

Panola  
 U-2000  
 2/16/78

MISSISSIPPI  
 BOARD OF WATER COMMISSIONERS  
 416 North State Street  
 Jackson, Mississippi 39201

WATER WELL DRILLERS LOG

2-16 1978 Lipc Well Co. Panola  
 date well completed firm name county well located

LANDOWNER:  
 Lessie Shaw  
 Pope MS.  
 (mailing address)

description of formations encountered	from	to
Top soil	0	20
red sand	20	40
gravel	40	60
clay	60	80
white sand	80	150

WELL LOCATION:  
 sec. 20 T. 10 N. R. 8 E. S. 3 W.  
 3 miles west of Pope  
 (distance) (direction) (nearest town)

WELL PURPOSE:  
 (home, irrigation, municipal, industrial)

- WELL COMPLETION DATA:
- (1) diameter (inches) 4
  - (2) total depth (feet) 150
  - (3) static water level (feet) 130 below top of ground.
  - (4) casing PVC, 140 (material) (depth)
  - 4 (size) if telescope see back.
  - (5) screen 10, 140 (length) (depth to top)
  - 4, PVC (size) (material)
  - (6) pump 3/4, 10 (HP) (yield gpm)
  - ~~elec~~ elec, (type power)
  - (7) electric log non (yes or no)
  - non (organization running log)
  - (8) how well bottom plugged PVC plug


RECEIVED  
 MAR - 9 1978

DRILLERS REMARKS:

MISS. BD. OF WATER COMM.

If well telescopes please sketch and show depths.

GROUND LEVEL

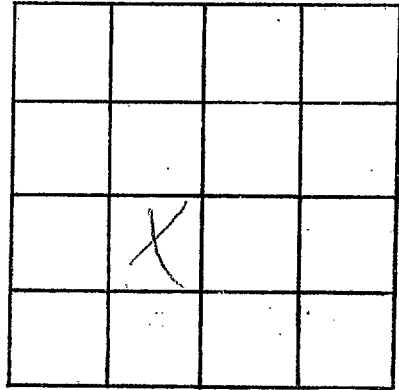

SECTION 20

Please indicate well location X.

ADDITIONAL INFORMATION

Lined area for additional information.

If more than one screen, show locations of each on sketch.