

PANOLA
 71-2008
 5-7-79

MISSISSIPPI
 BOARD OF WATER COMMISSIONERS
 416 North State Street
 Jackson, Mississippi 39201

WATER WELL DRILLERS LOG

3-5-79 19 29 North miss well Drilling Panola
 date well completed firm name county well located

LANDOWNER: <u>Caron Morris</u>	description of formations encountered	from	to
	Clay	0	25
(mailing address)	Gravel	25	40
WELL LOCATION: sec. <u>19</u> T <u>27</u> N R <u>3</u> E <u>3</u> miles <u>S-W</u> of <u>Pope</u> (distance) (direction) (nearest town)	Sand	40	156
WELL PURPOSE: <u>Home</u> (home, irrigation, municipal, industrial)			
WELL COMPLETION DATA:			
(1) diameter (inches) <u>4"</u>			
(2) total depth (feet) <u>153</u>			
(3) static water level (feet) <u>112</u> below top of ground.			
(4) casing <u>Plastic</u> <u>145'</u> (material) (depth)			
_____ if telescope see back. (size)			
(5) screen <u>10'</u> <u>145'</u> (length) (depth to top)			
_____ <u>4"</u> <u>Plastic</u> (size) (material)			
(6) pump <u>1/2</u> <u>12</u> (HP) (yield gpm)			
_____ <u>Elec</u> (type power)			
(7) electric log <u>no</u> (yes or no)			
_____ (organization running log)			
(8) how well bottom plugged <u>Wash Bot</u>			
DRILLERS REMARKS:			


Miss. Board of Water Comm.

JUL 30 1979

RECEIVED

If well telescopes please sketch and show depths.

GROUND LEVEL

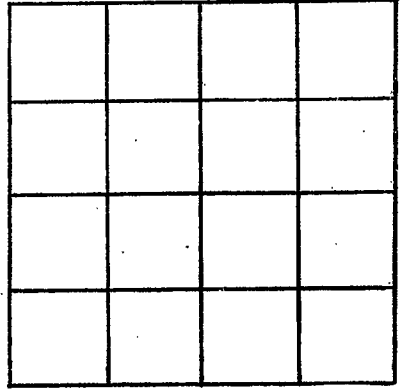

SECTION _____

Please indicate well location X.

ADDITIONAL INFORMATION

If more than one screen, show locations of each on sketch.