

MISSISSIPPI DEPARTMENT OF NATURAL RESOURCES

Bureau of Land and Water Resources

Southport Mall

P.O. Box 10631

Jackson, Mississippi 39209

WATER WELL DRILLERS LOG

Panola  
U-2010  
1/12/81  
1/12/81

date well completed

19

firm name

county well located

Lipe Well Supply Panola

LANDOWNER: Walter Dye

Batesville  
Miss

(mailing address)

WELL LOCATION:

sec. 5 T. 10 N. R. 2 E.  
6 S. W

(distance) miles (direction) of (nearest town)

WELL PURPOSE:  
 (home, irrigation, municipal, industrial)

WELL COMPLETION DATA:

- (1) diameter (inches) 4
- (2) total depth (feet) 218
- (3) static water level (feet) 150 below above top of ground.
- (4) casing PVC, 218,  
 (material) (depth)  
 (size) if telescope see back.
- (5) screen 8, 210  
 (length) (depth to top)  
4,  
 (size) (material)
- (6) pump 1, 15  
 (HP) (yield gpm)  
 (type power)
- (7) electric log (yes or no) (no)  
 (organization running log)
- (8) how well bottom plugged Cap

description of formations encountered

from

to

CLAY	8	20
Gravel	20	40
Gravel	40	60
CLAY	60	80
CLAY	80	100
CLAY	100	120
CLAY	120	140
CLAY	140	160
CLAY & SAND	160	180
SAND	180	200
	200	218

DRILLERS REMARKS:


DEPT OF NATURAL RESOURCES  
 BUREAU OF LAND & WATER RESOURCES

MAR - 9 1981

RECEIVED

If well telescopes please sketch and show depths.

GROUND LEVEL

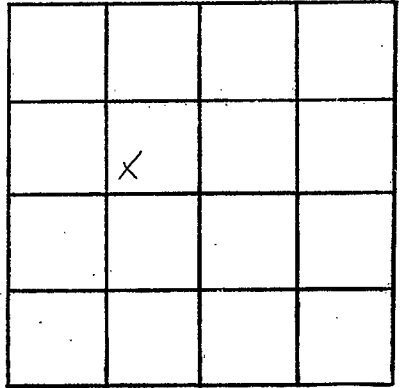

SECTION \_\_\_\_\_

Please indicate well location X.

ADDITIONAL INFORMATION

If more than one screen,  
show locations of each on sketch.