

MISSISSIPPI DEPARTMENT OF NATURAL RESOURCES

Bureau of Land and Water Resources

Southport Mall

P.O. Box 10631

Jackson, Mississippi 39209

WATER WELL DRILLERS LOG

PANOLA
U-2011

10-28 1985 LIPE WELLS & SUPPLY PANOLA
date well completed firm name county well located

LANDOWNER: DR ANDY GARROT
113 BENEKA ST.
BATESVILLE, MS
(mailing address)

WELL LOCATION:
sec. 11 T. 10 N. R. 8 E. S. 5
5 miles S of BATESVILLE
(distance) (direction) (nearest town)


WELL PURPOSE: HOME
(home, irrigation, municipal, industrial)

WELL COMPLETION DATA:

- (1) diameter (inches) 4"
- (2) total depth (feet) 190
- (3) static water level (feet) 120' below above top of ground.
- (4) casing PVC, 180,
(material) (depth)
 if telescope see back.
(size)
- (5) screen 10', 180
(length) (depth to top)
4, PVC
(size) (material)
- (6) pump 1, 18
(HP) (yield gpm)
230V 1Ø
(type power)
- (7) electric log NO
(yes or no)

(organization running log)
- (8) how well bottom plugged CAP

description of formations encountered	depth	
	from	to
top soil c.	0	17
sand	17	20
sand	20	30
blue clay	30	40
" "	40	60
" "	60	80
" "	80	85
sand	85	100
sand	100	115
clay	115	120
sand	120	140
sand	140	160
sand	160	180
sand	180	190

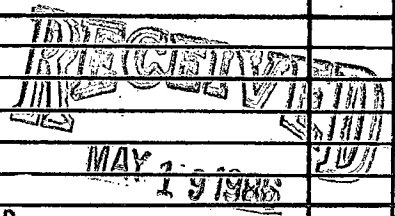


DRILLERS REMARKS:

Department of Natural Resources
Bureau of Land and Water Resources
JACKSON, MISSISSIPPI

If well telescopes please
sketch and show depths.

GROUND LEVEL

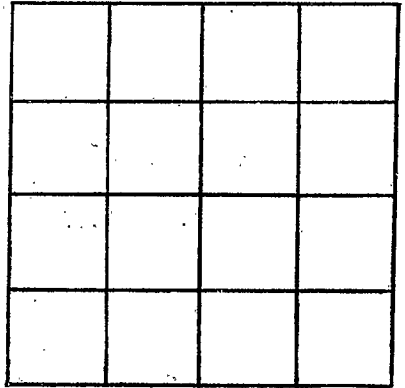

SECTION _____

Please indicate well location X.

ADDITIONAL INFORMATION

If more than one screen,
show locations of each on sketch.