

9-15-62

WATER WELL DRILLERS LOG

9-15-62

J B Carr

Panola

Date: _____, 19____, Driller: _____ County _____

(Name)

(1) Owner of Land: Mr Bright
Batesville Miss
 (Name)
 (Address)

Description & Color of Materials Sand, Clay, Red Clay, Shell, etc.	Thick- ness Feet	Depth Feet
<u>Sand</u>	<u>0</u>	<u>80</u>
<u>Clay</u>	<u>30</u>	<u>150</u>
<u>of Sand</u>	<u>150</u>	<u>182</u>

(2) Location: _____ 1/4, _____ 1/4, Sec. _____ T R _____
12 South Batesville
 _____ miles _____ of _____
 (distance) (direction) (Nearest Town)

(3) Topography: _____
 (Hilly) (Flat) (Level)
Home

(4) Purpose of Well: _____
 (Domestic Irrigation
 Municipal, Industrial, Other)

Information upon completion of well:

(1) Diameter 2 inches.

(2) Total Depth 180 feet.

(3) Water level 100 feet below top of ground.

(4) Cased to 1 1/4, Size 2"

(5) Screen: Size 1/4, Length 6 FT


(6) Were any formations sealed against pollution?

_____ yes, _____ no.

If YES depth of formation _____

Why _____

Drillers Remarks: _____

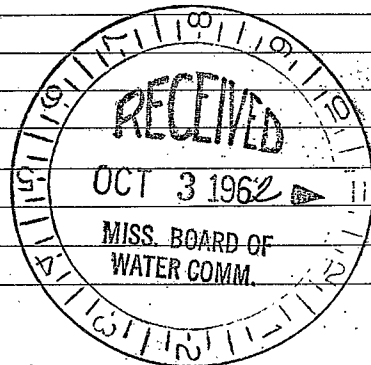

(Use Back Side).

Well No.

