

V

5-12-65

WATER WELL DRILLERS LOG

Date: 5-12, 1965, Driller: Jerry Robinson County Panola (Name)

(1) Owner of Land: Archie Paulk (Name)
 Pope, Miss (Address)

(2) Location: 1/4, 1/4, Sec. T R
 4 miles South of Pope (distance) (direction) (Nearest Town)

(3) Topography: (Hilly) (Flat) (Level)

(4) Purpose of Well: Home (Domestic Irrigation, Municipal, Industrial, Other)

Description & Color of Materials Sand, Clay, Red Clay, Shell, etc.	Thick- ness Feet	Depth Feet
Clay	0	30
Sand + Gravel	30	90
Sand	90	108

Information upon completion of well:

(1) Diameter 2 inches.

(2) Total Depth 108 feet.

(3) Water Level 80 feet below top of ground.

(4) Cased to 102, Size 2


(5) Screen: Size 1/4 in, Length 6 ft.
 Screen locked in

(6) Were any formations sealed against pollution?
 _____ yes, _____ no.

If YES depth of formation _____

Why _____

Drillers Remarks: Steel well

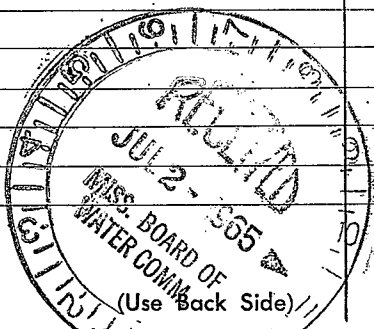

Well No.

