

PANOLA

WATER WELL DRILLERS LOG

Date 4-18-66, 1966, Driller: J. B. Cain County Panola

(Name)

(1) Owner of Land: E. O. Darby
(Name)
Pulp mill
(Address)

Description & Color of Materials Sand, Clay, Red Clay, Shell, etc.	Thick- ness Feet	Depth Feet
<u>Red Clay</u>	<u>0</u>	<u>30</u>
<u>Sand</u>	<u>30</u>	<u>30</u>
<u>Blue Clay</u>	<u>50</u>	<u>50</u>
<u>Sand</u>	<u>68</u>	<u>68</u>

(2) Location: 1/4, 1/4, Sec. T R
4 miles S of Pulp
(distance) (direction) (Nearest Town)

(3) Topography: 1
(Hilly) (Flat) (Level)

(4) Purpose of Well: Home
(Domestic Irrigation, Municipal, Industrial, Other)


Information upon completion of well:

- (1) Diameter 2 1/2 inches.
- (2) Total Depth 68 feet.
- (3) Water Level 25 feet below top of ground.
- (4) Cased to 68, Size 2 1/2
- (5) Screen: Size 3 1/2, Length 5 FT
Plastic screen
- (6) Were any formations sealed against pollution?
_____ yes, _____ no.

If YES depth of formation _____

Why _____

Drillers Remarks: _____

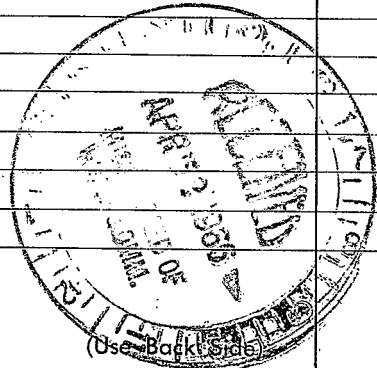

Well No. _____

