

log #20

Panola
V5
9-13-65
M.G.S.
sept 13
date well completed

MISSISSIPPI
BOARD OF WATER COMMISSIONERS
416 North State Street
Jackson, Mississippi 39201

CODED

WATER WELL DRILLERS LOG

JAMES R. LEE firm name
PANOLA county well located

LANDOWNER: POPE COURTLAND

Description of formations encountered	from	to
CLAY + SAND	0	60
CLAY	60	98
SAND	98	124
CLAY	124	325
SAND	325	395
SAND + CLAY	395	650
SAND	650	850

POPE MISS -
(mailing address)
WELL LOCATION:
sec. 9 T. 10 S. R. 7 W.
POPE miles POPE of POPE
(distance) (direction) (nearest town)

WELL PURPOSE: FNA
(home, irrigation, municipal, industrial)

- WELL COMPLETION DATA:
- (1) diameter (inches) 8
 - (2) total depth (feet) 825
 - (3) static water level (feet) 80' below top of ground.
 - (4) casing STEEL, 780' (material), (depth)
6" (size) if telescope see back.
 - (5) screen 30' length, 795' (depth to top)
0.12 (size), SS (material)
 - (6) pump 15 (HP), 150 (yield gpm)
EBC (type power)
 - (7) electric log YES (yes or no)
M.G.S. (organization running log)
 - (8) how well bottom plugged STEEL PLUG

CODED

DRILLERS REMARKS:

NONE

If well telescopes please sketch and show depths.


GROUND LEVEL

	X		

SECTION 9

Please indicate well location X.

ADDITIONAL INFORMATION

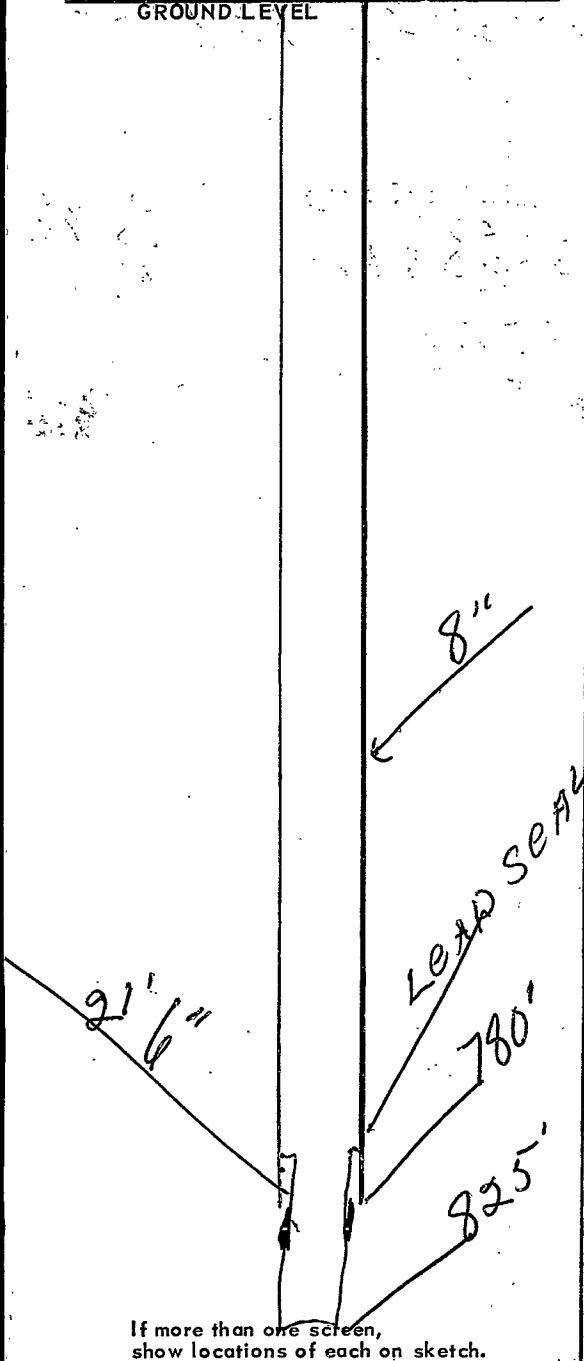

If more than one screen, show locations of each on sketch.