

PANOLA
 ✓ 9
 1-23-71

MISSISSIPPI
 BOARD OF WATER COMMISSIONERS
 416 North State Street
 Jackson, Mississippi 39201

CODED

WATER WELL DRILLERS LOG

1-23 1971 James R Life Panola
 date well completed firm name county well located

LANDOWNER: Tour Chef
 Pope Miss.
 (mailing address)

description of formations encountered	from	to
Clay	0	20
sand and clay	20	40
Gravel	40	60
Sand	60	85

WELL LOCATION:
 sec 10 T 10 N R 7 E
 1 miles East of POPE
 (distance) (direction) (nearest town)

WELL PURPOSE: Industrial
 (home, irrigation, municipal, industrial)

- WELL COMPLETION DATA:
- (1) diameter (inches) 4"
 - (2) total depth (feet) 85
 - (3) static water level (feet) 40 below top of ground.
 - (4) casing PVC 75' (material) (depth)
 4 (size) if telescope see back.
 - (5) screen 10 75' (length) (depth to top)
 4" PVC (size) (material)
 - (6) pump 3/4 10 (HP) (yield gpm)
 Elec. (type power)
 - (7) electric log no (yes or no)
 no (organization running log)
 - (8) how well bottom plugged PVC Plug

CODED


MAY 14 1971

DRILLERS REMARKS:

MISS. BD. OF
 WATER COMMISSIONERS

If well telescopes please sketch and show depths.

GROUND LEVEL

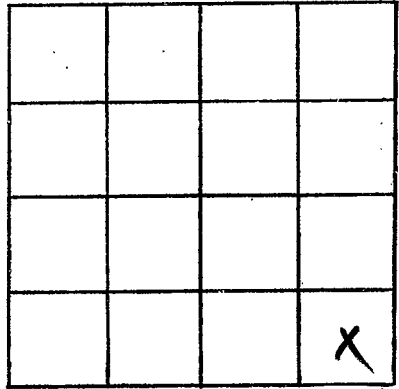

SECTION 10

Please indicate well location X.

ADDITIONAL INFORMATION

If more than one screen, show locations of each on sketch.