

ELOG #31

Panola
VII
6-28-68
USGS

MISSISSIPPI
BOARD OF WATER COMMISSIONERS
416 North State Street
Jackson, Mississippi 39201
WATER WELL DRILLERS LOG

CODED

June 28, 1968 date well completed
Luther Ratliff firm name
Panola county well located

LANDOWNER: Miss. State Hwy. Dept.
Batesville, MISS

(mailing address)

WELL LOCATION: Rt. Sta. 3164 34
Elev. 266 2
sec. 3 T. 10 N R. 7 E
1/4 miles EAST of COURTLAND
(distance) (direction) (nearest town)

WELL PURPOSE: Rest Area
(home, irrigation, municipal, industrial)

WELL COMPLETION DATA:

(1) diameter (inches) 4x2

(2) total depth (feet) 899

(3) static water level (feet) _____ below top of ground.

(4) casing 4" Black WROSE HT. IRON 315, (material) (depth)

(size) if telescope see back.

(5) screen SEE BACK (length) (depth to top)

(size) (material)

(6) pump S 30 (HP) (yield gpm)


Electric (type power)

(7) electric log yes (yes or no)

U.S. Geological Survey (organization running log)

(8) how well bottom plugged CAP

description of formations encountered	from	to
Clay	0	23
Gravel	23	63
Sand	63	103
Clay	103	163
Shale	163	263
Sand	263	323
Shale	323	343
Sand	343	443
Clay	443	483
Sand streaks	483	583
Clay	583	623
Sand streaks	623	703
Sand	703	763
Sand streaks	763	803
Sand	803	898

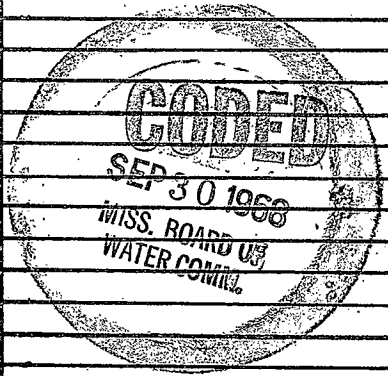

Jim & Reas Ogn
9/24/68 by Jubernick

DRILLERS REMARKS:

