

MISSISSIPPI BOARD OF WATER COMMISSIONERS
B. VERANOIA

7-10-60 V 12

WATER WELL DRILLERS LOG

CODED

Date: 7/10, 1960, Driller: James R Lipe County Panola
(Name)

(1) Owner of Land: Mrs. C. G. Sells
(Name)
Enid, Miss.
(Address)

(2) Location: $\frac{1}{4}$, $\frac{1}{4}$, Sec. 33 T 27 N R 3 E
5 miles NW, of Enid
(distance) (direction) (Nearest Town)

(3) Topography: (Hilly) (Flat) (Level)

(4) Purpose of Well: Domestic
(Domestic Irrigation, Municipal, Industrial, Other)

Description & Color of Materials Sand, Clay, Red Clay, Shell, etc.	Thick-ness Feet	Depth Feet
<u>Red Clay</u>	<u>30</u>	<u>0-30</u>
<u>Blue-gray clay</u>	<u>12</u>	<u>30-42</u>
<u>Gravel</u>	<u>39</u>	<u>42-81</u>
<u>Up heavy sand</u>	<u>80</u>	<u>81-91</u>

Information upon completion of well:

(1) Diameter 2 inches.


(2) Total Depth 91 feet.

(3) Water Level 20 feet below top of ground.

(4) Cased to 91, Size 2

(5) Screen: Size 1/4, Length 6

(6) Were any formations sealed against pollution?
yes, no.

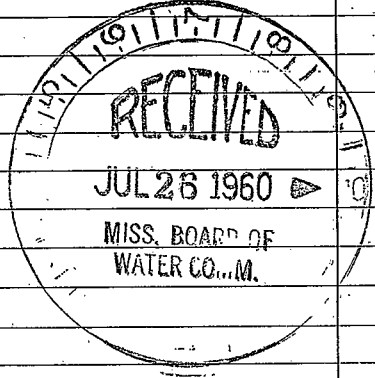

If YES depth of formation _____
Why _____

Drillers Remarks: _____

(Use Back Side)

