

V 13
7-28-60

WATER WELL DRILLERS LOG

Date: 7-28, 1960, Driller: James R Lipe County: Panola
(Name)

(1) Owner of Land: Louis Anthony Pope
(Name)
Pope
(Address)

(2) Location: 1/4, 1/4, Sec. 26 T10R7
4 miles SE, of Pope
(distance) (direction) (Nearest Town)

(3) Topography: (Hilly) (Flat) (Level)

(4) Purpose of Well: Dom
(Domestic Irrigation, Municipal, Industrial, Other)

Description & Color of Materials Sand, Clay, Red Clay, Shell, etc.	Thick- ness Feet	Depth Feet
<u>Red clay</u>	<u>30</u>	<u>0-30</u>
<u>Gravel</u>	<u>70</u>	<u>30-120</u>
<u>Heavy sand</u>	<u>15</u>	<u>120-135</u>

Information upon completion of well:

(1) Diameter 2 inches.

(2) Total Depth 135 feet.

(3) Water Level 125 feet below top of ground.

(4) Cased to 126, Size 2


(5) Screen: Size 1/4, Length 6

(6) Were any formations sealed against pollution?
yes, no,

If YES depth of formation _____

Why _____

Drillers Remarks: _____

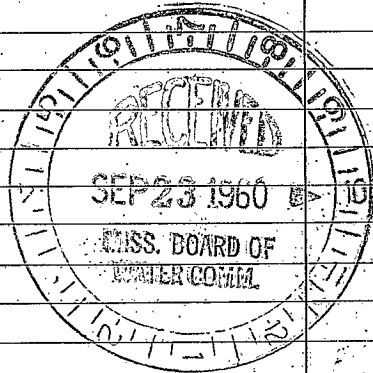

(Use Back Side)

Well No.

