

PANOLA

MISSISSIPPI BOARD OF WATER COMMISSIONERS

CODED

V 14  
8-15-60

WATER WELL DRILLERS LOG

V - 300

Date: 8-15, 1960, Driller: James R. Lipe County: Panola

(Name)

(1) Owner of Land: LEONARD HERMAN

(Name)

COURTLAND

(Address)

(2) Location: 1/4, 1/4, Sec. 4 10 3 R 2 E

miles Town of COURTLAND (direction) (Nearest Town)

(3) Topography: (Hilly) (Flat) (Level)

(4) Purpose of Well: Dam (Domestic Irrigation Municipal, Industrial, Other)

Description & Color of Materials Sand, Clay, Red Clay, Shell, etc.

Thick-ness Feet

Depth Feet

Gravel  
Sand  
Sand

50 50  
30 80  
15 95

Information upon completion of well:

(1) Diameter 20 inches.

(2) Total Depth 95 feet.

(3) Water Level 70 feet below top of ground.

(4) Cased to 81, Size 20


(5) Screen: Size 1/4, Length 6

(6) Were any formations sealed against pollution? yes, no.

If YES depth of formation

Why

Drillers Remarks:

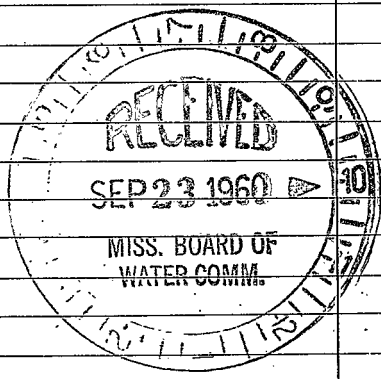

(Use Back Side)

Well No.

