

PANOLA

V 15

12-17-60

WATER WELL DRILLERS LOG

CODED (?)

Date 12/17/60, 1960, Driller: Jas. R. Lipe, County Panola

(Name)

(1) Owner of Land Mr. H. M. Brown

(Name)

Pape, Miss

(Address)

(2) Location: 1/4, 1/4, Sec. 16 T10R7S W

1 miles West of Pape

(distance)

(direction)

(Nearest Town)

(3) Topography: Hilly

(Hilly)

(Flat)

(Level)

(4) Purpose of Well Domestic

(Domestic Irrigation, Municipal, Industrial, Other)

Description & Color of Materials
Sand, Clay, Red Clay, Shell, etc.

Thick-
ness
Feet

Depth
Feet

Top soil & clay	0	10
clay	10	22
sandy gravel	25	25
red sand	25	50
uplying sand	50	68


Information upon completion of well:

- (1) Diameter 2 inches.
- (2) Total Depth 68 feet.
- (3) Water Level 50 feet below top of ground.
- (4) Cased to 60; Size 2
- (5) Screen: Size 1/4, Length 6'
- (6) Were any formations sealed against pollution?
yes, no.

If YES depth of formation

Why

Drillers Remarks:

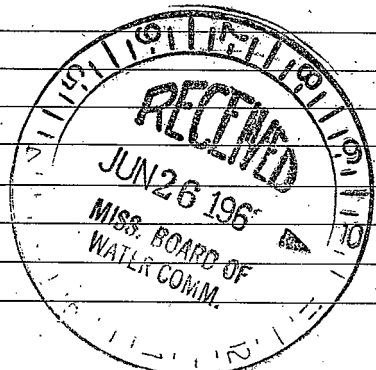

(Use Back Side)

Well No.

Retain this copy for your office files.

