

PANDOLA

MISSISSIPPI BOARD OF WATER COMMISSIONERS

V 20

11-3-62

WATER WELL DRILLERS LOG

CODED

Date: 11-3, 1962, Driller: James R. Lips County Pandola (Name)

(1) Owner of Land: <u>H.C. Hen</u> (Name) <u>Pope, Miss</u> (Address)	Description & Color of Materials Sand, Clay, Red Clay, Shell, etc.	Thickness Feet	Depth Feet
		<u>0</u>	<u>25</u>
(2) Location: <u>1/4, 1/4, Sec 24 T15R11</u> <u>3</u> miles <u>east</u> of <u>Pope</u> (distance) (direction) (Nearest Town)	<u>Red CLAY</u>	<u>25</u>	<u>40</u>
	<u>CLAY SAND</u>	<u>40</u>	<u>65</u>
(3) Topography: <u>Hilly</u> (Hilly) (Flat) (Level)	<u>SAND &amp; GRAVEL</u>	<u>65</u>	<u>90</u>
	<u>GRAVEL</u>	<u>90</u>	<u>116</u>
(4) Purpose of Well: <u>Dom.</u> (Domestic Irrigation Municipal, Industrial, Other)	<u>water bearing sand</u>		

Information upon completion of well:


- (1) Diameter 2 inches.
- (2) Total Depth 135 feet.
- (3) Water level 80 feet below top of ground.
- (4) Cased to 128, Size 2"
- (5) Screen: Size 1/4, Length 6'
- (6) Were any formations sealed against pollution?

yes, no.

If YES depth of formation

Why

Drillers Remarks:

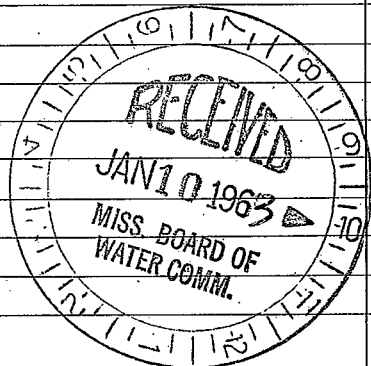

(Use Back Side)

Well No.

