

PANOLA

MISSISSIPPI BOARD OF WATER COMMISSIONERS

V 21

12-1-62

WATER WELL DRILLERS LOG

CODED

Date: 12-1, 1962, Driller: James R. Lips, County Panola (Name)

(1) Owner of Land:	Description & Color of Materials Sand, Clay, Red Clay, Shell, etc.	Thick- ness Feet	Depth Feet
J.C. Hubbard (Name) Covington, Miss. (Address)	Clay Chert sand Sand + gravel Sand, water	0 25 40 60	25 40 60 90
(2) Location: 1/4, 1/4, Sec. 13 T5 R7 4 miles east of Pope (distance) (direction) (Nearest Town)			
(3) Topography: level (Hilly) (Flat) (Level)			
(4) Purpose of Well: Domestic (Domestic Irrigation Municipal, Industrial, Other)			


Information upon completion of well:

- (1) Diameter 2 inches.
- (2) Total Depth 90 feet.
- (3) Water Level 50 feet below top of ground.
- (4) Cased to 83, Size 2"
- (5) Screen: Size 1/4, Length 6'
- (6) Were any formations sealed against pollution?
_____ yes, _____ no.

If YES depth of formation _____

Why _____

Drillers Remarks: _____

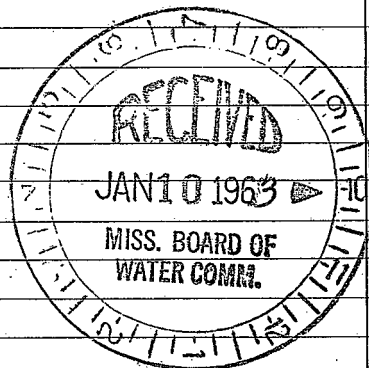

(Use Back Side)

Well No.

