

Date: 8-12, 1963, Driller: James R. Lipe County Panola  
8-12-63 (Name)

(1) Owner of Land: Mario McCracken  
(Name)  
Pape  
(Address)  
(2) Location: 1/4, 1/4, Sec. 17 273  
1/2 miles east of Pape  
(distance) (direction) (Nearest Town)  
(3) Topography: Hilly  
(Hilly) (Flat) (Level)  
(4) Purpose of Well: Dom  
(Domestic Irrigation  
Municipal, Industrial, Other)

Description & Color of Materials Sand, Clay, Red Clay, Shell, etc.	Thick- ness Feet	Depth Feet
<u>clay</u>	<u>0</u>	<u>15</u>
<u>black gravel</u>	<u>15</u>	<u>40</u>
<u>gravel</u>	<u>40</u>	<u>60</u>
<u>gravel + sand</u>	<u>60</u>	<u>80</u>
<u>1/2 sand</u>	<u>80</u>	<u>113</u>


Information upon completion of well:

- (1) Diameter 2 inches.
- (2) Total Depth 113' feet.
- (3) Water Level 60 feet below top of ground.
- (4) Cased to: 105, Size 2
- (5) Screen: Size 1/4, Length 6
- (6) Were any formations sealed against pollution?  
\_\_\_\_\_ yes,  no.

If YES depth of formation \_\_\_\_\_

Why \_\_\_\_\_

Drillers' Remarks: \_\_\_\_\_

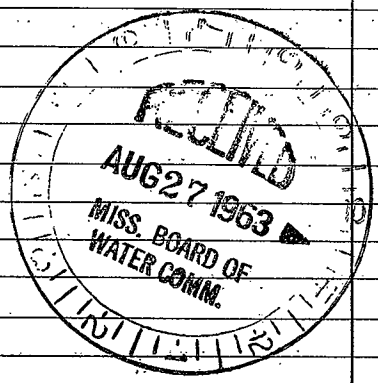

(Use Back Side)

Well No.

