

Date: Sept-9, 1963, Driller: James R. Lipe County Panola  
(Name)

(1) Owner of Land: 9-9-63 Shellie Bell  
(Name)  
Pape, Mrs  
(Address)

(2) Location: 1/4, 1/4, Sec. 22 T10 R 7 S  
3 miles east, of Pape  
(distance) (direction) (Nearest Town)

(3) Topography: Hilly  
(Hilly) (Flat) (Level)

(4) Purpose of Well: Dom.  
(Domestic Irrigation  
Municipal, Industrial, Other)

Description & Color of Materials Sand, Clay, Red Clay, Shell, etc.	Thick- ness Feet	Depth Feet
<u>Clay</u>	<u>0</u>	<u>25</u>
<u>General</u>	<u>25</u>	<u>60</u>
<u>Gravel &amp; Sand</u>	<u>60</u>	<u>100</u>
<u>W/ Sand</u>	<u>100</u>	<u>131</u>

Information upon completion of well:

(1) Diameter 2 inches.


(2) Total Depth 131 feet.

(3) Water Level 60 feet below top of ground.

(4) Cased to 122, Size 2"

(5) Screen: Size 1/4, Length 6'

(6) Were any formations sealed against pollution?  
 yes,  no.

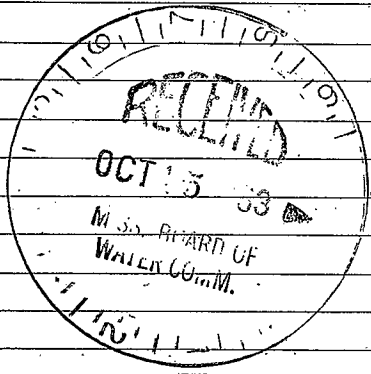

If YES depth of formation \_\_\_\_\_

Why \_\_\_\_\_

Drillers Remarks: \_\_\_\_\_

Well No. 12

(Use Back Side)

Date: \_\_\_\_\_, 19\_\_\_\_, Driller: \_\_\_\_\_ County \_\_\_\_\_

(Name)

(1) Owner of Land: \_\_\_\_\_  
(Name)

(Address)

(2) Location: \_\_\_\_\_ 1/4, \_\_\_\_\_ 1/4, Sec. \_\_\_\_\_ T \_\_\_\_\_ R \_\_\_\_\_

\_\_\_\_\_ miles \_\_\_\_\_ of \_\_\_\_\_  
(distance) (direction) (Nearest Town)

(3) Topography: \_\_\_\_\_  
(Hilly) (Flat) (Level)

(4) Purpose of Well: \_\_\_\_\_  
(Domestic Irrigation  
Municipal, Industrial, Other)

Information upon completion of well:

(1) Diameter \_\_\_\_\_ inches.

(2) Total Depth \_\_\_\_\_ feet.

(3) Water Level \_\_\_\_\_ feet below top of ground.

(4) Cased to \_\_\_\_\_, Size \_\_\_\_\_

(5) Screen: Size \_\_\_\_\_, Length \_\_\_\_\_

(6) Were any formations sealed against pollution?

\_\_\_\_\_ yes, \_\_\_\_\_ no.

If YES depth of formation \_\_\_\_\_

Why \_\_\_\_\_

Drillers Remarks: \_\_\_\_\_

Description & Color of Materials  
Sand, Clay, Red Clay, Shell, etc.

Thick-  
ness  
Feet

Depth  
Feet

(Use Back Side)

Well No.

Retain this copy for your office files.