

PANOLA

MISSISSIPPI BOARD OF WATER COMMISSIONERS

V 28

3-18-64

WATER WELL DRILLERS LOG

CODED

Date: Mar 18, 1964, Driller: Frank Taylor County Panola
(Name)

(1) Owner of Land: Ray mce
(Name)
Pape
(Address)

Description & Color of Materials Sand, Clay, Red Clay, Shell, etc.	Thick- ness Feet	Depth Feet
<u>Clay & Sand</u>	<u>0</u>	<u>70</u>
<u>upland</u>	<u>70</u>	<u>94</u>

(2) Location: 1/4, 1/4, Sec. 21 T. 10 R. 7
S W
1 miles South, of Pape
(distance) (direction) (Nearest Town)

(3) Topography: Hilly
(Hilly) (Flat) (Level)

(4) Purpose of Well: Domestic
(Domestic Irrigation
Municipal, Industrial, Other)

Information upon completion of well:

(1) Diameter 2 inches.

(2) Total Depth 94 feet.

(3) Water Level 50 feet below top of ground.

(4) Cased to 147, Size 2

(5) Screen: Size 1/4, Length 6


(6) Were any formations sealed against pollution?

no yes, no

If YES depth of formation _____

Why _____

Drillers Remarks: _____

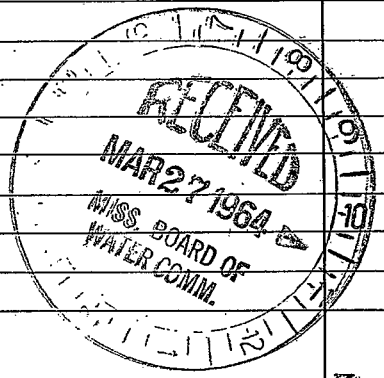

(Use Back Side)

Well No. 52

[The page contains extremely faint and illegible text, likely bleed-through from the reverse side of the document. No specific words or phrases can be discerned.]