

MISSISSIPPI BOARD OF WATER COMMISSIONERS

PANOLA

V 29

WATER WELL DRILLERS LOG

CODED

4-2-64

Date: April 2, 1964, Driller: Frank Taylor County Panola

(Name)

(1) Owner of Land: Mr. Malenke
 (Name)
Pope, Miss.
 (Address)

Description & Color of Materials
 Sand, Clay, Red Clay, Shell, etc.

Thick-
 ness
 Feet

Depth
 Feet

<u>Sand</u>	<u>0</u>	<u>35</u>
<u>Clay</u>	<u>35</u>	<u>125</u>
<u>water sand</u>	<u>125</u>	<u>137</u>

(2) Location: 1/4, 1/4, Sec. 25 T 27 N R 17 W
8 miles East, of Pope
 (distance) (direction) (Nearest Town)

(3) Topography: Hilly
 (Hilly) (Flat) (Level)

(4) Purpose of Well: Domestic
 (Domestic Irrigation
 Municipal, Industrial, Other)

Information upon completion of well:

(1) Diameter 2 inches.

(2) Total Depth 137 feet.

(3) Water Level 80 feet below top of ground.

(4) Cased to 126', Size 2"

(5) Screen: Size 1 1/4, Length 6'


(6) Were any formations sealed against pollution?

no yes, no

If YES depth of formation _____

Why _____

Drillers Remarks: _____

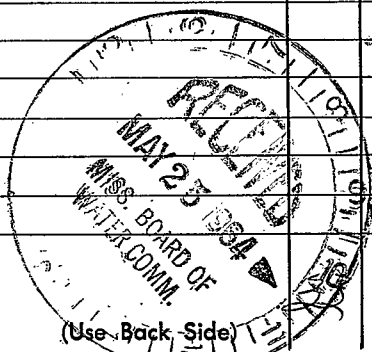

Well No. _____

