

Panola
 V 30
 6-14-65

MISSISSIPPI BOARD OF WATER COMMISSIONERS

James A. Lips
 WATER WELL DRILLERS LOG

CODED

Date: 6.14, 1965, Driller: Frank Ryland County Panola
 (Name)

(1) Owner of Land: Morris Darby
 (Name)
Batesville, Miss.
 (Address)
 (2) Location: 1/4, 1/4, Sec. 16 T¹⁰S R³E
6 miles South of Batesville
 (distance) (direction) (Nearest Town)
 (3) Topography: Hilly
 (Hilly) (Flat) (Level)
 (4) Purpose of Well: Domestic
 (Domestic Irrigation
 Municipal, Industrial, Other)


Description & Color of Materials Sand, Clay, Red Clay, Shell, etc.	Thick- ness Feet	Depth Feet
Clay Red	0	20
Clay and sand	20	40
Sand	40	60
Sand and gravel	60	80
" "	80	100
" "	100	120

Information upon completion of well:

(1) Diameter 2 inches.
 (2) Total Depth 120 feet.
 (3) Water Level 90 feet below top of ground.
 (4) Cased to 110, Size 2
 (5) Screen: Size 1/4, Length 10
 (6) Were any formations sealed against pollution?
 _____ yes, _____ no.

If YES depth of formation _____
 Why _____

Drillers Remarks: _____

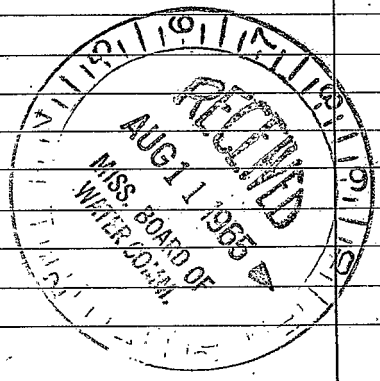

(Use Back Side)

Well No.

