

PANOLA MISSISSIPPI BOARD OF WATER COMMISSIONERS

V 31
5-27-66

James Ray Lips
WATER WELL DRILLERS LOG

CODED

Date: 5/27, 1966, Driller: Frank Tylon County Panola
(Name)

(1) Owner of Land: Jap Dougherty
(Name)
Pope
(Address)

(2) Location: 1/4, 1/4, Sec 26 27 28 29
3 miles So. of Pope
(distance) (direction) (Nearest Town)

(3) Topography: Hilly
(Hilly) (Flat) (Level)

(4) Purpose of Well: Drone
(Domestic Irrigation
Municipal, Industrial, Other)

Description & Color of Materials Sand, Clay, Red Clay, Shell, etc.	Thick- ness Feet	Depth Feet
<u>Gravel</u>	<u>0</u>	<u>50</u>
<u>red sand</u>	<u>50</u>	<u>75</u>
<u>red clay + sand</u>	<u>75</u>	<u>100</u>
<u>white sand</u>	<u>100</u>	<u>140</u>

Information upon completion of well:

(1) Diameter 4" inches.

(2) Total Depth 140 feet.

(3) Water Level 110 feet below top of ground.

(4) Cased to 136, Size 4"


(5) Screen: Size 4", Length 6"

(6) Were any formations sealed against pollution?
_____ yes, _____ no.

CODED

If YES depth of formation _____
Why _____

Drillers Remarks: _____

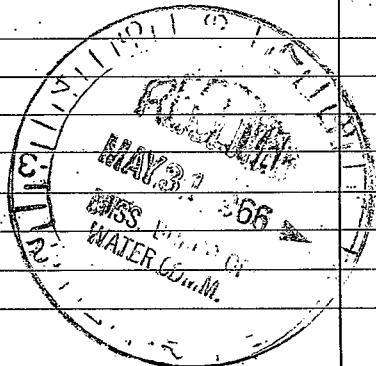

(Use Back Side)

Well No.

