

Panola
 V36
 7-3-69

MISSISSIPPI
 BOARD OF WATER COMMISSIONERS
 416 North State Street
 Jackson, Mississippi 39201

CODED

WATER WELL DRILLERS LOG

7-3, 1969 date well completed
 James R. Lipe firm name
 Panola county well located

LANDOWNER Carson Helem
 Courtland Miss.

description of formations encountered	from	to
Clay and Sand	0	20
Sand and gravel	20	40
" "	40	60
Sand Clay and gravel	60	70
Sand and clay	70	80
Sand	80	85
Clay and sand	85	100
Rocks and clay	100	120
Clay	120	140
" "	140	160
" "	160	180
Sand streak	180	190
" "	190	200
Good sand	200	220

(mailing address)
 WELL LOCATION:
 sec. 12 T. 16 N. R. 7 E.
 5 miles East of Courtland
 (distance) (direction) (nearest town)

WELL PURPOSE: Home
 (home, irrigation, municipal, industrial)

- WELL COMPLETION DATA:
- diameter (inches) 4
 - total depth (feet) 278
 - static water level (feet) 60 below top of ground.
 - casing Plastic, 208 (material) (depth)
 (size) if telescope see back.
 - screen 10' 208 (length) (depth to top)
 2' Plastic (size) (material)
 - pump 3/4 15 (HP) (yield gpm)
 Elec. (type power)
 - electric log no (yes or no)
 no (organization running log)
 - how well bottom plugged Plastic plug

JUL 9 - 1969

MISS. BD. OF
 WATER COM.

DRILLERS REMARKS: Rock at 85'

If well telescopes please sketch and show depths.


GROUND LEVEL

Casing

screen s

2 1/2" pipe with plug

If more than one screen, show locations of each on sketch.

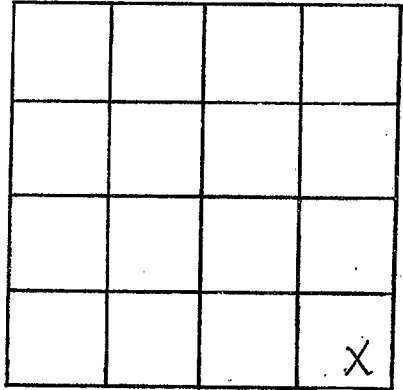

SECTION 12

Please indicate well location X.

ADDITIONAL INFORMATION

Lined area for providing additional information.