

PANOLA
V38
7-24-70

MISSISSIPPI
BOARD OF WATER COMMISSIONERS
416 North State Street
Jackson, Mississippi 39201

CODED

WATER WELL DRILLERS LOG

July 24 1970 Lipe Well Co. Panola
date well completed firm name county well located

LANDOWNER:
Mattie Holmes
Courtland
(mailing address)

WELL LOCATION:
sec. 2 T. 10 N. R. 7 E.
2 miles E of Courtland
(distance) (direction) (nearest town)

| description of formations encountered | from to | |
|---------------------------------------|---------|------|
| | feet | feet |
| clay | 0 | 20 |
| " " | 20 | 40 |
| gravel | 40 | 60 |
| sand and clay | 60 | 80 |
| " " " | 80 | 100 |
| sand | 100 | 138 |

WELL PURPOSE: home
(home, irrigation, municipal, industrial)

WELL COMPLETION DATA:

(1) diameter (inches) 4

(2) total depth (feet) 138

(3) static water level (feet) 70 below top of ground.

(4) casing PVC, 128' (material) (depth)
4" (size) If telescope see back.

(5) screen 10' length, 128' depth to top
4" (size) PVC (material)

(6) pump 1/2 HP, 10 (yield gpm)
Elec. (type power)

(7) electric log NO (yes or no)
NO (organization running log)

(8) how well bottom plugged PVC
PVC

CODED


AUG 24 1970

DRILLERS REMARKS:

MISS. RD. OF
WATER COMM.

If well telescopes please sketch and show depths.

GROUND LEVEL

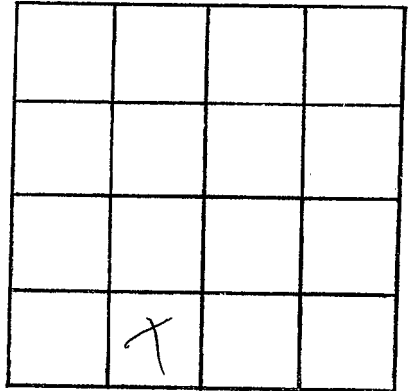

SECTION 2

Please indicate well location X.

ADDITIONAL INFORMATION

If more than one screen,
show locations of each on sketch.