

PANOLA
 ✓ 39
 8-3-70

MISSISSIPPI
 BOARD OF WATER COMMISSIONERS
 416 North State Street
 Jackson, Mississippi 39201

CODED

WATER WELL DRILLERS LOG

Aug 3 1970 LiPe Well Co Panola
 date well completed firm name county well located

LANDOWNER: Milton Brown
POPE MISS.
 (mailing address)

description of formations encountered	from	to
CLAY	0	20
SAND	20	40
"	40	60
"	60	77

WELL LOCATION:
 sec 17 T. 10 N. R. 3 E
1 miles West of POPE
 (distance) (direction) (nearest town)

WELL PURPOSE: home
 (home, irrigation, municipal, industrial)

WELL COMPLETION DATA:

(1) diameter (inches) 2

(2) total depth (feet) 77

(3) static water level (feet) 30 below top of ground.

(4) casing PVC 77
 (material) (depth)
2 if telescope see back.
 (size)

(5) screen 5 77
 (length) (depth to top)
2 PVC
 (size) (material)

(6) pump 3/4 8
 (HP) (yield gpm)
Elec
 (type power)

(7) electric log no
 (yes or no)
no
 (organization running log)

(8) how well bottom plugged PVC
plug

CODED


AUG 24 1970

MISS. BD. OF
 WATER COMM.

DRILLERS REMARKS:

If well telescopes please sketch and show depths.

GROUND LEVEL

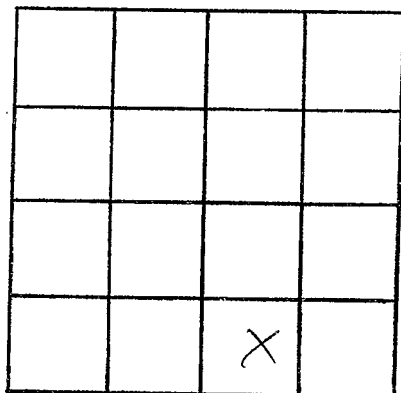

SECTION 17

Please indicate well location X.

ADDITIONAL INFORMATION

If more than one screen, show locations of each on sketch.