

PANOLA
V41
1-31-72

MISSISSIPPI
 BOARD OF WATER COMMISSIONERS
 416 North State Street
 Jackson, Mississippi 39201

CODED

WATER WELL DRILLERS LOG

1-31 19 72 PIPE WELL CO. Panola
 date well completed firm name county well located


LANDOWNER: <u>Roy Waire</u> <u>POPE MISS.</u>	description of formations encountered	from	to
	<u>top soil</u>	<u>0</u>	<u>10</u>
	<u>gravel</u>	<u>10</u>	<u>30</u>
	<u>sand</u>	<u>30</u>	<u>109</u>
(mailing address)			
WELL LOCATION:			
sec. <u>21</u> T <u>12</u> N R <u>7</u> <u>W</u>			
<u>1</u> miles <u>South</u> of <u>POPE</u>			
(distance) (direction) (nearest town)			
WELL PURPOSE: <u>HOME</u>			
(home, irrigation, municipal, industrial)			
WELL COMPLETION DATA:			
(1) diameter (inches) <u>4"</u>			
(2) total depth (feet) <u>104</u>			
(3) static water level (feet) <u>72</u> below above top of ground.			
(4) casing <u>PVC</u> <u>96'</u>			
(material) (depth)			
<u>4"</u> if telescope see back.			
(size)			
(5) screen <u>8'</u> <u>96'</u>			
(length) (depth to top)			
<u>4</u> <u>PVC</u>			
(size) (material)			
(6) pump <u>3/4</u> <u>10</u>			
(HP) (yield gpm)			
<u>elec.</u>			
(type power)			
(7) electric log <u>NO</u>			
(yes or no)			
<u>NO</u>			
(organization running log)			
(8) how well bottom plugged <u>PVC</u>			
<u>DIUG</u>			
DRILLERS REMARKS:			

CODED

APR 27 1972

If well telescopes please sketch and show depths.

GROUND LEVEL

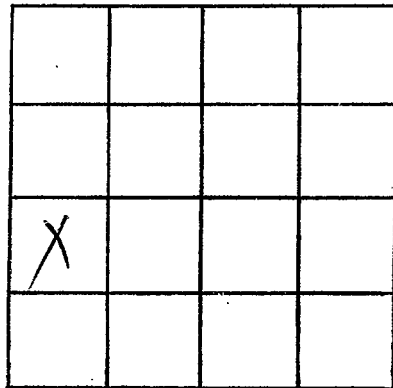

SECTION 21

Please indicate well location X.

ADDITIONAL INFORMATION

If more than one screen,
show locations of each on sketch.