

PANOLA
 V42
 3-1-72

MISSISSIPPI
 BOARD OF WATER COMMISSIONERS
 416 North State Street
 Jackson, Mississippi 39201

CODED

WATER WELL DRILLERS LOG

3-1 1972 PIPE WELL CO. Panola
 date well completed firm name county well located

LANDOWNER: James Webb
 Pope Miss.

description of formations encountered	from	to
sand & clay	0	20
gravel	20	60
coarse sand	60	72

(mailing address)

WELL LOCATION:

sec. 13 T. 9 N R. 7 E
 5 miles east of Pope
 (distance) (direction) (nearest town)

WELL PURPOSE: none
 (home, irrigation, municipal, industrial)

WELL COMPLETION DATA:

- (1) diameter (inches) 4"
- (2) total depth (feet) 72
- (3) static water level (feet) 10 below top of ground.
- (4) casing PVC, 64' (material) (depth)
 4 (size) if telescope see back.
- (5) screen 8, 64 (length) (depth to top)
 4, PVC (size) (material)
- (6) pump 3/4, 10 (HP) (yield gpm)
 elec. (type power)
- (7) electric log No (yes or no)
 No (organization running log)
- (8) how well bottom plugged PVC plug

CODED

JUL 27 1972

MISS. BD. OF WATER COMMISSIONERS


JUL 27 1972

MISS. BD. OF WATER COMMISSIONERS

DRILLERS REMARKS:

If well telescopes please sketch and show depths.

GROUND LEVEL

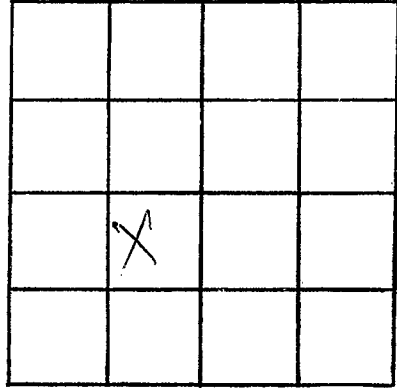

SECTION 13

Please indicate well location X.

ADDITIONAL INFORMATION

Lined area for additional information.

If more than one screen, show locations of each on sketch.