

PANOLA
V43
6-9-72

MISSISSIPPI
BOARD OF WATER COMMISSIONERS
416 North State Street
Jackson, Mississippi 39201

CODED

WATER WELL DRILLERS LOG

June 9 1972 J.B. Cain Panola
date well completed firm name county well located

LANDOWNER: Ma Blair

| description of formations encountered | from | to |
|---------------------------------------|------|-----|
| Clay | 0 | 20 |
| Sand | 20 | 90 |
| Blue Clay | 90 | 105 |
| Sand | 105 | 136 |

(mailing address)

WELL LOCATION:

sec. 1 T 10 N R 7 E
3 miles W of Eukieha Sp
(distance) (direction) (nearest town)

WELL PURPOSE: Home
(home, irrigation, municipal, industrial)

WELL COMPLETION DATA:

- (1) diameter (inches) 4"
- (2) total depth (feet) 136
- (3) static water level (feet) 70 below top of ground.
- (4) casing Plastic, 136 (material), (depth)
- (size) If telescope see back.
- (5) screen 10' 126 (length), (depth to top)
4" Plastic (size), (material)
- (6) pump 1/2 (HP) 11 (yield gpm)
Elec (type power)
- (7) electric log NO (yes or no)

CODED

(organization running log)

(8) how well bottom plugged Plug


JUN 17 1972

DRILLERS REMARKS:

WISS. L
MISSISSIPPI

If well telescopes please sketch and show depths.

GROUND LEVEL

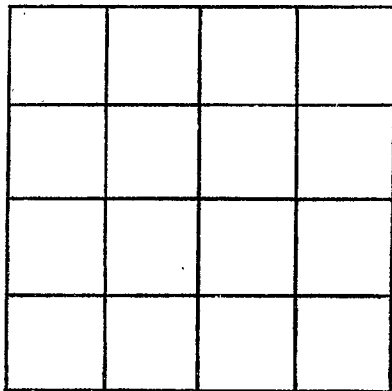

SECTION _____

Please indicate well location X.

ADDITIONAL INFORMATION

If more than one screen, show locations of each on sketch.