

PANOLA

✓ 44

11-1-72

MISSISSIPPI
 BOARD OF WATER COMMISSIONERS
 416 North State Street
 Jackson, Mississippi 39201

WATER WELL DRILLERS LOG

CODED
Panola

11-1-1972 date well completed

JAMES R. LIPE firm name

Panola county well located

LANDOWNER: J. H. MOORE

POPE

MISS.

(mailing address)

description of formations encountered

from

to

sand and gravel

0

20

sand

30

40

sand

40

60

WELL LOCATION:

sec 20 T 10 N R 50
2 miles S.E. of POPE
 (distance) (direction) (nearest town)

WELL PURPOSE: HOME (home, irrigation, municipal, industrial)

WELL COMPLETION DATA:

- (1) diameter (inches) 4
- (2) total depth (feet) 60
- (3) static water level (feet) 40 below above top of ground.
- (4) casing PVC, 50 (material) (depth)
4 if telescope see back. (size)
- (5) screen 10, 50 (length) (depth to top)
4, PVC (size) (material)
- (6) pump 3/4, 15 (HP) (yield gpm)
Elec. (type power)
- (7) electric log NO (yes or no)
NO (organization running log)
- (8) how well bottom plugged PVC
plug

Well OK


CODED

DEC 28 1972

DRILLERS REMARKS:

If well telescopes please sketch and show depths.

GROUND LEVEL

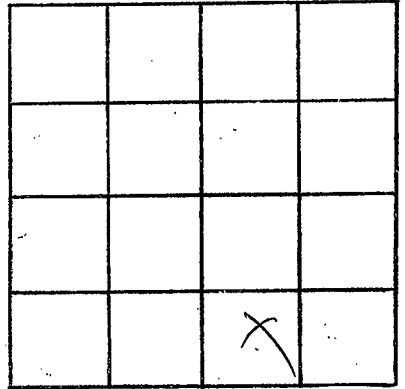

SECTION 20

Please indicate well location X.

ADDITIONAL INFORMATION

If more than one screen,
show locations of each on sketch.