

Panola  
V 46  
2-67

MISSISSIPPI  
BOARD OF WATER COMMISSIONERS  
416 North State Street  
Jackson, Mississippi 39201

**CODED**

WATER WELL DRILLERS LOG

2-25 1967 Peterson & Son Panola  
date well completed firm name county well located

LANDOWNER: Boyd Ford

description of formations encountered from to

St 1  
Courtland, Miss 38606  
(mailing address)

Clay + gravel 0 20  
Sand 20 30

WELL LOCATION:


sec. 12 T. 10 N R. 7 E  
S SE W  
6 miles of Batesville  
(distance) (direction) (nearest town)

WELL PURPOSE: Home  
(home, irrigation, municipal, industrial)

WELL COMPLETION DATA:

- (1) diameter (inches) 2"
- (2) total depth (feet) 30 ft
- (3) static water level (feet) 8 ft below top of ground.
- (4) casing Plastic, 25 ft (material) (depth)  
2" (size) if telescope see back.
- (5) screen 5 ft, 25 ft (length) (depth to top)  
3" (size), gravel packed (material)
- (6) pump 1/2 (HP) 12 (yield gpm)  
110 ZVA (type power)
- (7) electric log no (yes or no)  
(organization running log)
- (8) how well bottom plugged Caged

**CODED**

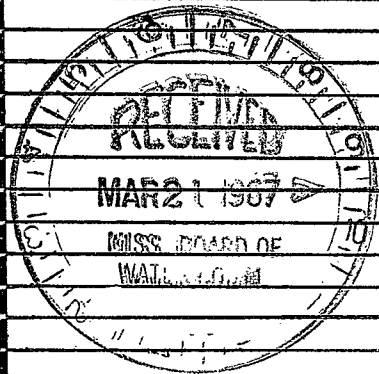

DRILLERS REMARKS: Plastic

Water Well

If well telescopes please sketch and show depths.

GROUND LEVEL

		⊗	
		X	

SECTION \_\_\_\_\_

Please indicate well location X.

ADDITIONAL INFORMATION

If more than one screen, show locations of each on sketch.