

PANOLA
 V47
 5-15-73

MISSISSIPPI
 BOARD OF WATER COMMISSIONERS
 416 North State Street
 Jackson, Mississippi 39201

CODED

WATER WELL DRILLERS LOG

May 15 1973 B. B. Cain Panola
 date well completed firm name county well located
Big Bear Well Drilling Co.

LANDOWNER: Ronie Cook
Richa

description of formations encountered	from	to
<u>Clay</u>	0	20
<u>Gravel</u>	20	70
<u>Sand</u>	70	135

(mailing address)

WELL LOCATION:
 sec. 2 T. 10 N. R. 7 E.
2 miles E of Richa
 (distance) (direction) (nearest town)

WELL PURPOSE:
 (home, irrigation, municipal, industrial)

WELL COMPLETION DATA:

(1) diameter (inches) 4"

(2) total depth (feet) 135

(3) static water level (feet) 65 below top of ground.

(4) casing Plastic 135
 (material) (depth)
 (size) if telescope see back.

(5) screen 10' 125
 (length) (depth to top)
4" Plastic
 (size) (material)

(6) pump 1/2 10
 (HP) (yield gpm)
Elec
 (type power)

(7) electric log No
 (yes or no)

(organization running log)

(8) how well bottom plugged plug


CODED

DRILLERS REMARKS:

MAY 18 1973

If well telescopes please sketch and show depths.

GROUND LEVEL

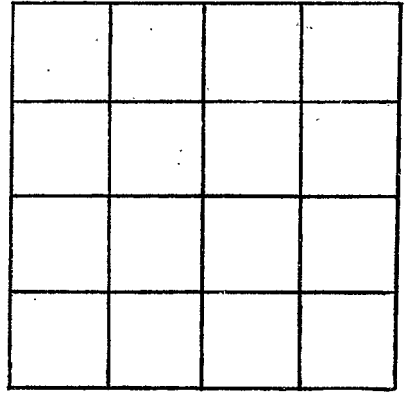

SECTION _____

Please indicate well location X.

ADDITIONAL INFORMATION

If more than one screen, show locations of each on sketch.