

PANOLA
V48
10-10-73

MISSISSIPPI
BOARD OF WATER COMMISSIONERS
416 North State Street
Jackson, Mississippi 39201

CODED

WATER WELL DRILLERS LOG

10-10 date well completed 1973 Lipe well Co. firm name Panola county well located

LANDOWNER:

Archie Pope
POME Miss.
(mailing address)

description of formations encountered

from	to
0	20
20	40
40	60
60	80
80	100
100	120
120	140
140	160

TOP soil
clay
sand
gravel
ll
ll
sand
ll

WELL LOCATION:

sec. 19 T 10 N R 3 E W 2
2 miles west of Pope
(distance) (direction) (nearest town)

WELL PURPOSE:

(home) irrigation, municipal, industrial

WELL COMPLETION DATA:

- (1) diameter (inches) 4
- (2) total depth (feet) 160
- (3) static water level (feet) 110 below above top of ground.
- (4) casing PVC 150 (material) (depth)
4 (size) if telescope see back.
- (5) screen 10 150 (length) (depth to top)
4 PVC (size) (material)
- (6) pump 3/4 10 (HP) (yield gpm)
elec (type power)
- (7) electric log NO (yes or no)
NO (organization running log)
- (8) how well bottom plugged PVC Plug


CODED

DRILLERS REMARKS:

NOV 5 1973

If well telescopes please sketch and show depths.

GROUND LEVEL

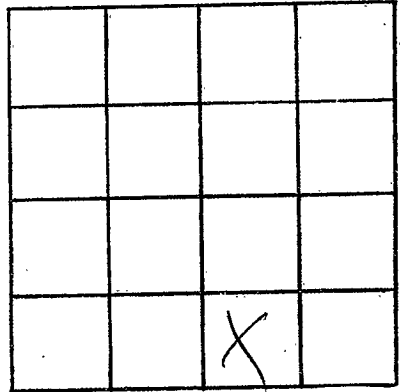

SECTION 19

Please indicate well location X.

ADDITIONAL INFORMATION

If more than one screen,
show locations of each on sketch.