

Parola
V 52
5-19-75

MISSISSIPPI
 BOARD OF WATER COMMISSIONERS
 416 North State Street
 Jackson, Mississippi 39201

CODED

WATER WELL DRILLERS LOG

W.A. Mason
Water Well Contractor

Parola

5-19-1975 date well completed

firm name

county well located

LANDOWNER:
Ezio Morgan
Pope Miss.
 (mailing address)

description of formations encountered	from	to
<u>clay loam</u>	<u>10</u>	<u>12</u>
<u>yellow clay</u>	<u>12</u>	<u>30</u>
<u>Red sand + gravel</u>	<u>30</u>	<u>118</u>
<u>Black clay</u>	<u>at</u>	<u>118</u>


WELL LOCATION:
 sec 27 T 10 N R 7 E 15F
2 1/2 miles SE of Pope
 (distance) (direction) (nearest town)

WELL PURPOSE: Home
 (home, irrigation, municipal, industrial)

- WELL COMPLETION DATA:
- (1) diameter (inches) 4"
 - (2) total depth (feet) 118'
 - (3) static water level (feet) 108' below above top of ground
 - (4) casing Plastic 95'
 (material) (depth)
4" if telescope see back.
 (size)
 - (5) screen 23' 95'
 (length) (depth to top)
4" Plastic
 (size) (material)
 - (6) pump 1/3 4
 (HP) (yield gpm)
electric
 (type power)
 - (7) electric log No
 (yes or no)
- (organization running log)

(8) how well bottom plugged
Cap on screen


DRILLERS REMARKS:

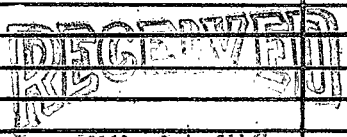

MAY 1 1975

If well telescopes please sketch and show depths.

GROUND LEVEL

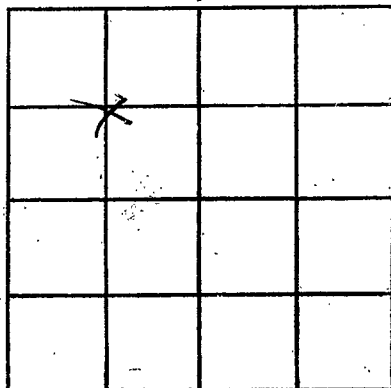

S 27

Please indicate well location X.

ADDITIONAL INFORMATION

If more than one screen, show locations of each on sketch.