

County: POPE
 Permit #: _____
 Driller: FRANK LANGFORD
 Date drilling completed: 9-29-06

Well Driller Report and Well Log

Mississippi Department of Environmental Quality
 Office of Land and Water Resources
 P.O. Box 10631
 Jackson, MS 39289-0631
 (601)961-5210
 (601)354-6938 (fax)

For Office Use Only:
 Aquifer: _____
 Well #: V-68
 L. S. Elevation: _____
 E-log #: _____

State Law requires that this report be prepared by the driller in detail and filed with the Department within 30 days of completion of drilling of the well.

Well Owner Information	Well Location
Owner Name: <u>AMY SIMON</u>	Latitude: _____ Longitude: _____
Mailing Address: <u>151 NELSON SPUR RD</u>	Method of Lat/Long (circle one): Conventional Survey, USGS quad, Hand-held GPS, Survey-grade GPS
<u>POPE</u> <u>MS</u>	<u>1/4</u> <u>1/4</u> Sec <u>20</u> Twn <u>109</u> Rng <u>7W</u>
City State Zip Code	Distance Direction Nearest Town
Telephone No. () _____	<u>2</u> Miles <u>SW</u> of <u>POPE</u>

Well Data

Purpose of Well (circle one) Home Industrial Public Supply Irrigation Fish Culture Other: _____

Date well drilling started: 9-26-06 Date well drilling completed: 9-29-06

If flowing, method of flow regulation: Valve _____ Other (describe) _____

Static Water Level: 120 feet above or below (circle one) land surface Date measured: _____

Method of Measurement (circle one) steel tape electric tape air line other: _____

Hole depth: 200 Well depth: 200 Well grouted to a depth of 10 feet

Type of grout (circle one): Cement Bentonite Mix

Casing length: 20 feet Casing diameter: 4 inches Type of casing: PVC

Screen length: 10 feet Screen diameter: 4 inches Type of screen: 510T PVC

Screen slot size: 0.10 inches Setting depth: From 190 feet to 200 feet

Type of completion (circle all applicable): Gravel packed Underreamed Telescoped Open hole Natural Development

Other (describe): _____

Top of lap pipe or reduction in casing: _____ feet. If telescoped or more than one screen, describe on back of page

Logs run (circle all applicable): No log run Electric Gamma Ray Density Sonic Neutron Other: _____

Name of organization running log(s): _____

I certify that the well was drilled, constructed, and completed in accordance with all applicable requirements of the Mississippi Department of Environmental Quality and/or the Mississippi Department of Health regulations and state laws.

FRANK LANGFORD 0-622 Frank Langford
 Print Name of Water Well Contractor and License No. Signature of Water Well Contractor

RECEIVED
 OCT 13 2006
 BY: OLWR

If well telescopes please sketch below and show depths.

V-68

Ground Level


Description of Formations Encountered

From To

Description of Formations Encountered	From	To
DIRT	0	10
R/SAND	10	20
CLAY	20	40
See GRAVEL	40	70
CLAY + SAND	70	100
w/CLAY	100	120
SAND	120	200

If more than one screen, show location of each on sketch

Sketch the property layout and include the following: 1) the well location; 2) any permanent structures on the property that may aid in locating the well; 3) any roads, power lines, or other items that may aid in locating the property and the well; 4) indicate direction.

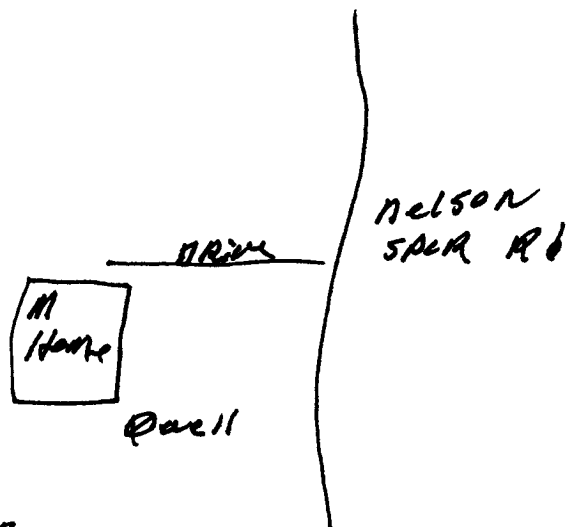

Landowner Name: RAY Slaughter

Frank Langford
 Signature of Water Well Contractor

RECEIVED
 OCT 13 2006
 BY: OLWR

STATE WELL REPORT

Part 2

Pump Installer's Completion Report

Mississippi Department of Environmental Quality
Office of Land and Water Resources
P. O. Box 10631
Jackson, MS 39289-0631
(601)961-5210
(601)354-6938 (fax)

For Office Use Only

Well No. V-68

File No. _____

County POPLAR

Permit # _____

Drafter FLANAGAN

Date completed 9-29-06

This report must be prepared by the pump installer in detail and filed with the Department within 30 days of the installation of pump. A copy of Part 1 of this report must be attached to this report.

Well Owner Information	Well Location
Owner Name: <u>ARY SLAUGHTER</u>	Latitude: _____ Longitude: _____
Mailing Address: <u>151 NELSON SPUR</u>	Method of Lat/Long (circle one): Conventional Survey, USGS quad, Hand-held GPS, Survey-grade GPS
<u>POPE</u> MS City State Zip Code	1/4 Sec <u>20</u> Twn <u>10 S</u> Rng <u>7 W</u>
Telephone No. (_____) _____	Distance Direction Nearest Town <u>2</u> Miles <u>SW</u> of <u>POPE</u>

Pump Type Circle one	Power Type Circle one
Air Lift Jet <u>Submersible</u>	Diesel Engine Gasoline Engine Natural Gas
Bucket Piston Turbine	<u>Electric Motor</u> Hand Tractor PTO
Centrifugal Rotary Flowing Well	Windmill Other (specify): _____
Other (specify): _____	Horse Power Rating of Motor: <u>3/4</u>
Date Pump Installed: <u>9-29-06</u>	Setting Depth: <u>140</u> feet
Rated Pump Capacity: <u>15</u> Gallons Per Minute	Number of Stages: <u>12</u>

Pump Test Data	Method of Measuring Water Level Circle one
Date Well Tested: <u>9-29-06</u>	Air Line Electric Measuring Line <u>Steel Tape</u>
Static Water Level (A): <u>120</u> Feet Below Land Surface	Other (specify): _____
Pumping Water Level (B): <u>120</u> Feet Below Land Surface	For flowing well, measured shut in head: _____ feet
Drawdown [(B) - (A)]: <u>5</u> Feet Below Land Surface	Well yielded <u>15+</u> GPM with a drawdown of
Test Pumping Rate: <u>15+</u> Gallons Per Minute	<u>5</u> feet after <u>4 1/2</u> hours of pumping
Duration of Pump Test (minimum 4 hours): <u>4 1/2</u> hours	

I HEREBY CERTIFY that the above statements are true to the best of my knowledge

FRANK LANGFORD 0-622
Print Name of Pump Installer and License No. (if applicable)

RECEIVED
Frank Langford
Signature of Pump Installer: OCT 13 2006

BY: OLWR