

PANOLA

V-2000

3-25-76

MISSISSIPPI  
 BOARD OF WATER COMMISSIONERS  
 416 North State Street  
 Jackson, Mississippi 39201

WATER WELL DRILLERS LOG

3-25

1976 Lipe well Co.

Panola

date well completed

firm name

county well located

LANDOWNER:

Jake Hawkins

Courtland MS.  
(mailing address)

description of formations encountered

from

to

TOP soil	0	20
sand	20	40
lc	40	60
white clay	60	80
clay and sand	80	100
sand	100	120
lc fine	120	138

WELL LOCATION:

sec. 12 T 10 N R 4 E  
 (S) (W)  
4 miles East of Courtland  
 (distance) (direction) (nearest town)

WELL PURPOSE:


(home, irrigation, municipal, industrial)

WELL COMPLETION DATA:

- (1) diameter (inches) 4
- (2) total depth (feet) 138
- (3) static water level (feet) 70 below above top of ground.
- (4) casing PVC, 128  
(material) (depth)  
4 If telescope see back.  
(size)
- (5) screen 10, 128  
(length) (depth to top)  
4, PVC  
(size) (material)
- (6) pump 3/4, 10  
(HP) (yield gpm)  
elec.  
(type power)
- (7) electric log no  
(yes or no)  
no  
(organization running log)

(8) how well bottom plugged PVC  
CAP


DRILLERS REMARKS:

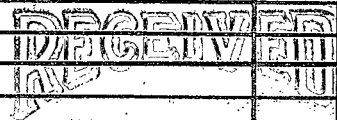

MAR 29 1976

If well telescopes please sketch and show depths.

GROUND LEVEL

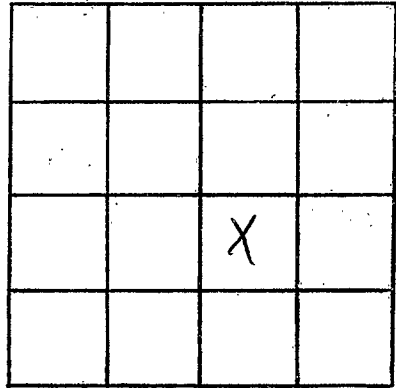

SECTION 12

Please indicate well location X.

ADDITIONAL INFORMATION

If more than one screen, show locations of each on sketch.