

Panola
V-2003
12-13-76

MISSISSIPPI
 BOARD OF WATER COMMISSIONERS
 416 North State Street
 15F Jackson, Mississippi 39201

WATER WELL DRILLERS LOG

12-13 1976 Lipe Well Co. Panola
 date well completed firm name county well located

LANDOWNER:
John Shegog
Enid MS.
 (mailing address)

| description of formations encountered | from | to |
|---------------------------------------|-----------------|------------|
| | <u>Top soil</u> | <u>0</u> |
| <u>sand</u> | <u>20</u> | <u>40</u> |
| <u>il</u> | <u>40</u> | <u>80</u> |
| <u>gravel</u> | <u>80</u> | <u>100</u> |
| <u>sand</u> | <u>100</u> | <u>120</u> |
| <u>il</u> | <u>120</u> | <u>160</u> |

WELL LOCATION:
 sec. 19 T. 25 N. R. 3 E.
10 S. 7 W.
2 miles S.W. of POPE
 (distance) (direction) (nearest town)

WELL PURPOSE:
 (home irrigation, municipal, industrial)

WELL COMPLETION DATA:

(1) diameter (inches) 4

(2) total depth (feet) 160

(3) static water level (feet) 90 below above top of ground.

(4) casing PVC 150
 (material) (depth)

4 If telescope see back.
 (size)

(5) screen 10 150
 (length) (depth to top)

4 PVC
 (size) (material)

(6) pump 3/4 10
 (HP) (yield gpm)

elec.
 (type power)

(7) electric log NON
 (yes or no)

NON
 (organization running log)


(8) how well bottom plugged PVC
cap

RECEIVED
 DEC 20 1976

DRILLERS REMARKS:

If well telescopes please sketch and show depths.

GROUND LEVEL

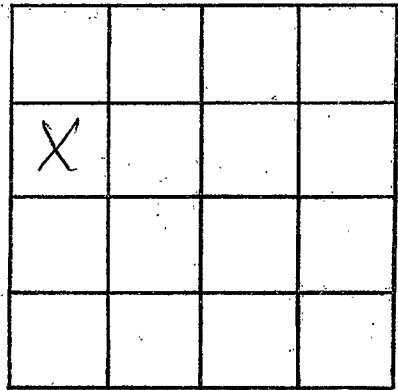

SECTION 19

Please indicate well location X.

ADDITIONAL INFORMATION

If more than one screen, show locations of each on sketch.