

Panola
 V-2005
 12/8/77

MISSISSIPPI
 BOARD OF WATER COMMISSIONERS
 416 North State Street
 Jackson, Mississippi 39201

WATER WELL DRILLERS LOG

12-8 1977 Life Well Co Panola
 date well completed firm name county well located

LANDOWNER:
 Shelton Hentz
 Pope, MS
 (mailing address)

description of formations encountered	from	to
Top Soil	0	20
sand	20	40
gravel	40	60
sand	60	80
sand	80	113

WELL LOCATION:
 sec. 11 T. 10 N. R. 7 E.
 2 miles East of Pope
 (distance) (direction) (nearest town)

WELL PURPOSE:
 (home) irrigation, municipal, industrial

- WELL COMPLETION DATA:
- (1) diameter (inches) 4
 - (2) total depth (feet) 113
 - (3) static water level (feet) 60 below top of ground.
 - (4) casing PVC 1103 (material) (depth)
 4 (size) if telescope see back.
 - (5) screen 10 103 (length) (depth to top)
 4 PVC (size) (material)
 - (6) pump 3/4 10 (HP) (yield gpm)
 Elec. (type power)
 - (7) electric log NON (yes or no)
 NON (organization running log)
 - (8) how well bottom plugged PVC cap


DRILLERS REMARKS:

RECEIVED
 DEC 27 1977

MISS. BD. OF WATER COMMISSIONERS

If well telescopes please sketch and show depths.

GROUND LEVEL

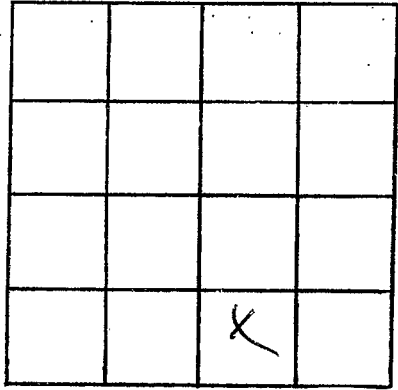

SECTION 11

Please indicate well location X.

ADDITIONAL INFORMATION

Lined area for additional information.

If more than one screen, show locations of each on sketch.