

PANOLA
V-2000

MISSISSIPPI DEPARTMENT OF NATURAL RESOURCES
 Bureau of Land and Water Resources
 Southport Mall
 P.O. Box 10631
 Jackson, Mississippi 39209
WATER WELL DRILLERS LOG

11-21 1990 LIFE WELL & SUPPLY CO., INC. PANOLA
 date well completed firm name county well located

LANDOWNER: JOHNNY MORGAN
CROSSROAD BUILDERS
P.O. Box 291
WINONA, MS.
 (mailing address)

| description of formations encountered | from | to |
|---------------------------------------|------|-----|
| Top soil, red sand, soft clay | 0 | 20 |
| soft clay, gravel, soft clay | 20 | 40 |
| soft clay, hard clay, rock, gravel | 40 | 60 |
| clay, rock, clay | 60 | 80 |
| clay, rock, sand, rock | 80 | 100 |

WELL LOCATION:
 sec 27 T 10 N R 7 E
 (S) (W)
2 miles EAST of POPE
 (distance) (direction) (nearest town)

WELL PURPOSE: HOME
 (home, irrigation, municipal, industrial)

- WELL COMPLETION DATA:
- (1) diameter (inches) 4
 - (2) total depth (feet) 100
 - (3) static water level (feet) _____ below above top of ground.
 - (4) casing PVC 90
 (material) (depth)
4 if telescope see back.
 (size)
 - (5) screen 10 90
 (length) (depth to top)
4 PVC
 (size) (material)
 - (6) pump 1/3 _____
 (HP) (yield gpm)
 (type power)
 - (7) electric log _____
 (yes or no)
 (organization running log)
 - (8) how well bottom plugged Capped

RECEIVED


APR 16 1991

Dept. of Environmental Quality
 Bureau of Land & Water Resources

DRILLERS REMARKS: _____

If well telescopes please sketch and show depths.

GROUND LEVEL

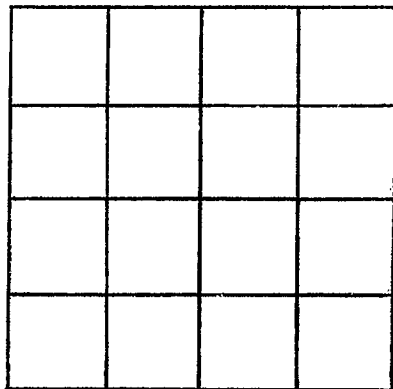

SECTION _____

Please indicate well location X.

ADDITIONAL INFORMATION

If more than one screen,
show locations of each on sketch.