

MISSISSIPPI DEPARTMENT OF ENVIRONMENTAL QUALITY
Bureau of Land and Water Resources

P. O. Box 10631
Jackson, MS 39289-0631
WATER WELL DRILLERS LOG

COUNTY WELL LOCATED
Panola 2007

WELL NUMBER 11-324 CODED

DATE WELL COMPLETED 11/14/92

PERMIT NUMBER

NAME OF DRILLING FIRM
Diye Well Supply

NAME & MAILING ADDRESS OF LANDOWNER
Lawrence Poque
Rt 1

Pope Ms 38658

WELL LOCATION: SEC 34 TOWNSHIP N 7 E RANGE 7

DISTANCE 5 Miles DIRECTION S of NEAREST TOWN Pope

OTHER LANDMARK

WELL PURPOSE: Home, Irrigation, Municipal, Industrial, Fish Pond, etc.

PUMP DATA

PUMP TYPE (Circle One):
 Submersible, Turbine, Jet, Flowing Well,
Other (Describe)

POWER TYPE (Circle One):
 Electric, Tractor, Diesel, Gasoline, Butane,
Other (Describe) H/P

Pump Capacity (GPM) 10 No. of Stages Setting Depth 135 FT.

PUMP TEST

Well yielded 10 GPM with
a drawdown of 15 ft.
after 1 hours of pumping

WELL DATA

Well Depth <u>144</u>	Casing Diameter (In.) <u>4</u>	Casing Length (Ft.) <u>134</u>
Type of Casing <u>PVC</u>	Hole Depth <u>144</u>	Depth to Static Water Level <u>90</u>

TYPE OF COMPLETION: (Circle One or More):
 Gravel Packed, Underreamed, Telescoped,
 Natural Development, Open Hole, Other

Top of Lap Pipe or Reduction in Casing

FEET IF TELESCOPED OR MORE THAN ONE SCREEN: USE BACK PAGE

LOG DATA

TYPE OF LOG RUN (Circle One):
 No Log Run,
Electric, Gamma Ray, Density, Sonic, Neutron,
Other (Describe)

Name of Organization Running Log

SCREEN DATA

Diameter - Inches <u>4"</u>	Length - Feet <u>10"</u>	Slot Size - Inches <u>.010</u>
Screen Type <u>PVC</u>	Depth to Bottom - Feet <u>144</u>	

GEOLOGIC DATA (Office Use Only)

Surface Elev.	Geologic Unit	Unit Thickness	Depth to Top
Subs. SWL	Date	Analysis	Aquifer Test


Driller's Remarks

DESCRIPTION OF FORMATIONS ENCOUNTERED	FROM	TO	FORMATIONS (Continued)	FROM	TO
<u>Topsoil</u>	<u>0</u>	<u>10</u>	RECEIVED JUN 03 1993 Dept. of Environmental Quality Office of Land & Water Resources		
<u>Sand</u>	<u>10</u>	<u>40</u>			
<u>Sand + Gravel</u>	<u>40</u>	<u>90</u>			
<u>Sand</u>	<u>90</u>	<u>144</u>			

IF MORE SPACE IS NEEDED, USE BACK

If well telescopes please
sketch and show depths.

GROUND LEVEL

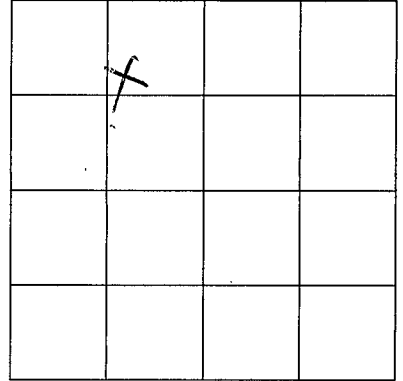

SECTION 34

Please indicate well location X.

ADDITIONAL INFORMATION

If more than one screen,
show location of each on sketch.