

MISSISSIPPI DEPARTMENT OF NATURAL RESOURCES

Bureau of Land and Water Resources

Southport Mall

P.O. Box 10631

Jackson, Mississippi 39209

WATER WELL DRILLERS LOG

PANOLA
V. 2008

4-16-92 19 Lipe Well Supply Panola
 date well completed firm name county well located

LANDOWNER: Mike Corcoran
PO Box Rt Bn 359
Rope Ms 38658
 (mailing address)


WELL LOCATION:
 sec. 27 T. 21 N R. 7 E
10 S 10 S of Rope
 (distance) miles (direction) of (nearest town)

WELL PURPOSE: home
 (home, irrigation, municipal, industrial)

WELL COMPLETION DATA:

(1) diameter (inches) 4"
 (2) total depth (feet) 122
 (3) static water level (feet) 60 below above top of ground.
 (4) casing PVC 112
 (material) (depth)
4" if telescope see back.
 (size)
 (5) screen 10 112
 (length) (depth to top)
4 PVC
 (size) (material)
 (6) pump 3/4 10
 (HP) (yield gpm)
elec
 (type power)
 (7) electric log no
 (yes or no)
 (organization running log)
 (8) how well bottom plugged PVC cap

description of formations encountered	from	to
top soil then peagranul sand	0	20
red gravel sand w/ peagranul & clay	20	40
Red gravel sand w/ break & clay at bottom	40	60
hard brick (61' back to clay)	60	70
upk 71' clay	70	80
clay, shell rock 83'	80	90
hard clay		
Clay	90	100
Shell rock clay about 2'	100	110
sand w/ little clay		
sand back to clay	110	120

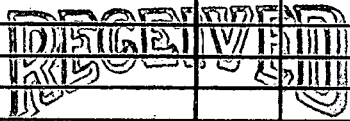


Dept. of Environmental Quality
 Bureau of Land & Water Resources

DRILLERS REMARKS:

If well telescopes please
sketch and show depths.

GROUND LEVEL

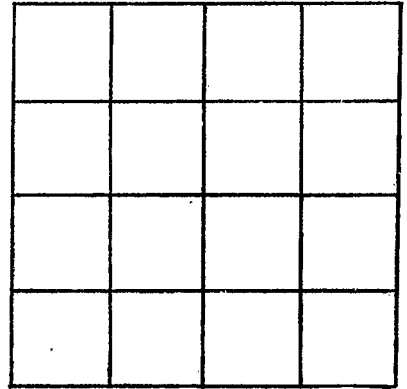

SECTION _____

Please indicate well location X.

ADDITIONAL INFORMATION

If more than one screen,
show locations of each on sketch.