

MISSISSIPPI
 BOARD OF WATER COMMISSIONERS
 416 North State Street
 Jackson, Mississippi 39201

WATER WELL DRILLERS LOG

✓
 2910
 6-1-92

date well completed

19

firm name

county well located

Lipe Well Supply

Panola

LANDOWNER

Lawrence Freyer

description of formations encountered

from

to

P.O. Box 102
 Courland, MS
 (mailing address)

Top soil, clay, gravel
 gravel clay, w/ streaks
 of gravel
 clay w/ some streaks
 of gravel
 gravel to about 74'

from	to
0	20
20	40
40	60
60	80

WELL LOCATION:

sec. 4 T. 10 N R. 7 E
 15 miles W of Courland
 (distance) (direction) (nearest town)

WELL PURPOSE: irrigation
 (home, irrigation, municipal, industrial)

WELL COMPLETION DATA:

- (1) diameter (inches) 4"
- (2) total depth (feet) 74'
- (3) static water level (feet) — below top of ground.
- (4) casing PVC 64' (material) (depth)
 4" (size) if telescope see back.
- (5) screen 10 64 (length) (depth to top)
 4" PVC (size) (material)
- (6) pump — (HP) — (yield gpm)
 — (type power)
- (7) electric log — (yes or no)
 — (organization running log)
- (8) how well bottom plugged —

RECEIVED


JUN 19 1992

Dept. of Environmental Quality
 Bureau of Land & Water Resources

DRILLERS REMARKS:

If well telescopes please sketch and show depths.

GROUND LEVEL

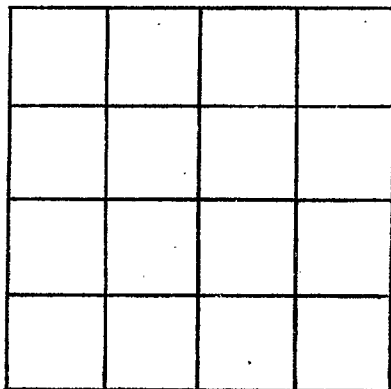

SECTION _____

Please indicate well location X.

ADDITIONAL INFORMATION

If more than one screen, show locations of each on sketch.