

MISSISSIPPI DEPARTMENT OF ENVIRONMENTAL QUALITY

Office of Land and Water Resources

P. O. Box 10631
Jackson, MS 39289-0631
WATER WELL DRILLERS LOG

COUNTY WELL LOCATED
Panola

WELL NUMBER CODED
V-2012

DATE WELL COMPLETED
Oct 29, 1999

PERMIT NUMBER

NAME OF DRILLING FIRM
Lipe Wells Supply

NAME & MAILING ADDRESS OF LANDOWNER
Ernie Fields

5197 Gloucester St

Memphis, TN 38135

WELL LOCATION SEC TOWNSHIP RANGE
35 10 N 7 E

DISTANCE DIRECTION NEAREST TOWN
1 Miles NW of Enid Lake

OTHER LANDMARK

WELL PURPOSE Home Irrigation, Municipal, Industrial, Fish Pond, etc.

PUMP DATA

PUMP TYPE (Circle One):
 Submersible, Turbine, Jet, Flowing Well,
Other (Describe) _____

POWER TYPE (Circle One):
 Electric, Tractor, Diesel, Gasoline, Butane,
Other (Describe) 3/4 H/P SW

Pump Capacity (GPM) No. of Stages Setting Depth
10 _____ 100 FT.

PUMP TEST

Well yielded 20 GPM with
a drawdown of _____ ft.
after _____ hours of pumping

WELL DATA

Well Depth <u>117</u>	Casing Diameter (In) <u>4"</u>	Casing Length (Ft) <u>100</u>
Type of Casing <u>PVC</u>	Hole Depth <u>117</u>	Depth to Static Water Level <u>78</u>

TYPE OF COMPLETION: (Circle One or More):
 Gravel Packed, Underreamed, Telescoped,
 Natural Development, Open Hole, Other
(Describe) _____

LOG DATA

TYPE OF LOG RUN (Circle One): No Log Run,
Electric, Gamma Ray, Density, Sonic, Neutron,
Other (Describe) _____

Name of Organization Running Log

WELL GROUTED TO A DEPTH OF _____ FEET
Type Grout (circle one): Cement, Bentonite, or Mix

GEOLOGIC DATA (Office Use Only)

Surface Elev.	Geologic Unit	Unit Thickness	Depth to Top
Subs. SWL	Date	Analysis	Aquifer Test


SCREEN DATA

Diameter - Inches <u>4</u>	Length - Feet <u>10</u>	Slot Size - Inches <u>.014</u>
Screen Type <u>WIRE WRAP PVC</u>	Depth to Bottom - Feet <u>117</u>	

Driller's Remarks
Set on rock just under gravel

Top of Lap Pipe or Reduction in Casing

FEET IF TELESCOPED OR MORE THAN ONE SCREEN: USE BACK PAGE

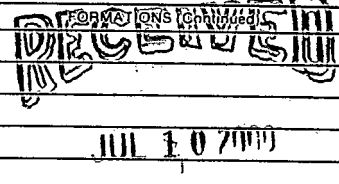
DESCRIPTION OF FORMATIONS ENCOUNTERED	FROM	TO	FORMATIONS (continued)	FROM	TO
TOP SOIL	0	20			
Red SAND - Pink CLAY	20	40			
Heavy GRAVEL SAND	40	60			
GRAVEL	60	70			
CLAY	70	90			
SAND	90	117			
ROCK	117	118			

Dept. of Environmental Quality
Office of Land & Water Resources

IF MORE SPACE IS NEEDED, USE BACK

If well telescopes please sketch and show depths.

GROUND LEVEL

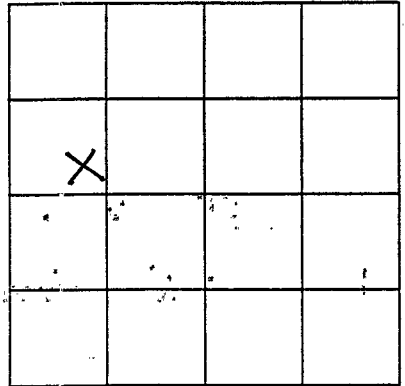

SECTION 35

Please indicate well location X.

ADDITIONAL INFORMATION

If more than one screen,
show location of each on sketch.