

W
9-1-63

WATER WELL DRILLERS LOG

Date: 9-1, 1963, Driller: T B CAIN County Panola

(Name)

(1) Owner of Land: Louis Bolden
(Name)
Pope Miss
(Address)

(2) Location: 1/4, 1/4, Sec. T R R
5 miles East, of Pope
(distance) (direction) (Nearest Town)

(3) Topography: ✓
(Hilly) (Flat) (Level)

(4) Purpose of Well: Home
(Domestic Irrigation
Municipal, Industrial, Other)

Description & Color of Materials Sand, Clay, Red Clay, Shell, etc.	Thick- ness Feet	Depth Feet
<u>Clay</u>	<u>0</u>	<u>30</u>
<u>Gravel & Shell</u>	<u>30</u>	<u>90</u>
<u>Sand</u>	<u>90</u>	<u>130</u>

Information upon completion of well:

(1) Diameter 2 inches.

(2) Total Depth 130 feet.

(3) Water Level 80 feet below top of ground.


(4) Cased to 130, Size 2"

(5) Screen: Size 1/4, Length 6 FT
LOCKED IN PIPE

(6) Were any formations sealed against pollution?
_____ yes, _____ no.

If YES depth of formation _____
Why _____

Drillers Remarks: _____

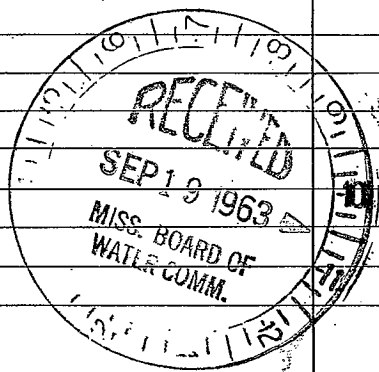

(Use Back Side)

Well No.

