

PANOLA

MISSISSIPPI BOARD OF WATER COMMISSIONERS

W

6-1-65

WATER WELL DRILLERS LOG

Date: 6-1, 1965, Driller: Jerry Peterson County Panola

(1) Owner of Land: Mr Mc Bride  
 (Name)  
Batesville, Miss  
 (Address)

(2) Location: 1/4, 1/4, Sec.     T     R      
1/2 miles west of Cumbo  
 (distance) (direction) (Nearest Town)

(3) Topography:      
 (Hilly) (Flat) (Level)

(4) Purpose of Well: Home  
 (Domestic Irrigation  
 Municipal, Industrial, Other)

Description & Color of Materials Sand, Clay, Red Clay, Shell, etc.	Thick-ness Feet	Depth Feet
<u>Clay</u>	<u>0</u>	<u>20</u>
<u>Sand + Clay</u>	<u>20</u>	<u>50</u>
<u>Gravel</u>	<u>50</u>	<u>70</u>
<u>Sand</u>	<u>70</u>	<u>90</u>
<u>Gravel</u>	<u>90</u>	<u>110</u>
<u>Blue Clay</u>	<u>110</u>	<u>180</u>
<u>Sand</u>	<u>180</u>	<u>195</u>

Information upon completion of well:

(1) Diameter 2 inches.

(2) Total Depth 195 feet.

(3) Water Level 100 feet below top of ground.

(4) Cased to 190, Size 2


(5) Screen: Size 3in, Length 5ft

(6) Were any formations sealed against pollution?  
    yes,     no.

If YES depth of formation    

Why    

Drillers Remarks: Plastic well

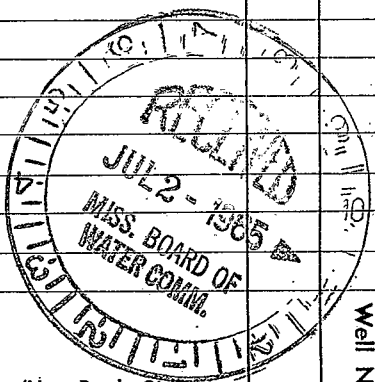

(Use Back Side)

