

PANOLA

W

MISSISSIPPI BOARD OF WATER COMMISSIONERS

6-23-66

WATER WELL DRILLERS LOG

Date: 6-23, 1966, Driller: Jerry Roberson, County Panola  
(When well drilled) (Name) (Where well is located)

(1) Owner of Land: Mr. J. C. Bowden  
(Name)  
Rt 1, Batesville, Miss  
(Address)

(2) Location: 1/4, 1/4, Sec.     T.     R.      
14 miles S. E., of B. V. Lk.  
(distance) (direction) (Nearest Town)

(3) Topography: ✓  
(Hilly) (Flat) (Level)

(4) Purpose of Well: Home  
(Domestic Irrigation, Municipal, Industrial, Other)

Description & Color of Materials Sand, Clay, Red Clay, Shell, etc.	Thick- ness Feet	Depth Feet
<u>Red Clay</u>	<u>0</u>	<u>20</u>
<u>Red sand</u>	<u>20</u>	<u>60</u>
<u>White Clay + Sand</u>	<u>60</u>	<u>90</u>
<u>Sand</u>	<u>90</u>	<u>108</u>

Information upon completion of well:

(1) Diameter 2 inches.

(2) Total Depth 108 feet.

(3) Water Level 70 feet below top of ground.

(4) Cased to 100, Size 2 in

(5) Screen: Size 3 in, Length 8 ft

(6) Were any formations sealed against pollution?  
    yes, ✓ no.

If YES depth of formation \_\_\_\_\_


Why \_\_\_\_\_

Drillers Remarks: Plastic well

Yield in gpm: 4 gal

Size pump: 1 H.P.

Type power: 220

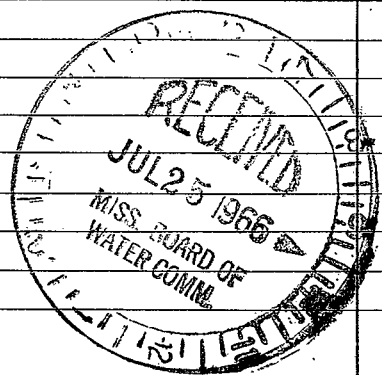

Mail this copy to Board of Water Commissioners 429 Miss. St. Jackson, Miss.

Handwritten signature or mark at the bottom left of the page.