

PANOLA

MISSISSIPPI BOARD OF WATER COMMISSIONERS

W

3-5-66

WATER WELL DRILLERS LOG

Date: 3-5, 1966, Driller: J B Cain County Panola

(Name)

(1) Owner of Land: Mc Mann
(Name)

Curica
(Address)

(2) Location: 1/4, 1/4, Sec. T. R.
2 miles E of Curica
(distance) (direction) (Nearest Town)

(3) Topography: (Hilly) (Flat) (Level)

(4) Purpose of Well: Home
(Domestic Irrigation, Municipal, Industrial, Other)

Description & Color of Materials
Sand, Clay, Red Clay Shell, etc.

Thick-
ness
Feet

Depth
Feet

<u>Bro Clay</u>	<u>0</u>	<u>20</u>
<u>Gravel</u>	<u>20</u>	<u>45</u>
<u>Sand</u>	<u>45</u>	<u>60</u>

Information upon completion of well:

(1) Diameter 2" inches.

(2) Total Depth 60 feet.

(3) Water Level 40 feet below top of ground.

(4) Cased to 60, Size 2"


(5) Screen: Size 3", Length 5 FT
Plastic

(6) Were any formations sealed against pollution?
 yes, no.

If YES depth of formation

Why

Drillers Remarks:

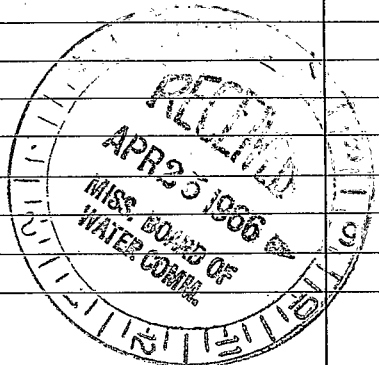

(Use Back Side)

Well No.

[The page contains extremely faint and illegible text, likely bleed-through from the reverse side of the document. No specific words or phrases can be discerned.]