

PANOLA

W

MISSISSIPPI BOARD OF WATER COMMISSIONERS

6-22-66

WATER WELL DRILLERS LOG


Date: 6-22, 1966, Driller: Jerry Robinson County Panola
(When well drilled) (Name) (Where well is located)

(1) Owner of Land: Mr. William McSee
(Name)
Rt. 1, Batesville, Miss
(Address)
(2) Location: 1/4, 1/4, Sec. T R
12 miles S-E of B'ville
(distance) (direction) (Nearest Town)
(3) Topography: (Hilly) (Flat) (Level)
(4) Purpose of Well: Home
(Domestic Irrigation
Municipal, Industrial, Other)

Description & Color of Materials Sand, Clay, Red Clay, Shell, etc.	Thick- ness Feet	Depth Feet
Clay	0	20
Sand + Clay	20	80
Sand	80	120

Information upon completion of well:
(1) Diameter 2 inches.
(2) Total Depth 120 feet.
(3) Water Level 90 feet below top of ground.
(4) Cased to 115, Size 2 in
(5) Screen: Size 3 in, Length 5 ft
(6) Were any formations sealed against pollution?
_____ yes, _____ no.

If YES depth of formation _____
Why _____
Drillers Remarks: Plastic Well
Yield in gpm: 5
Size pump: 1 H.P.
Type power: 110

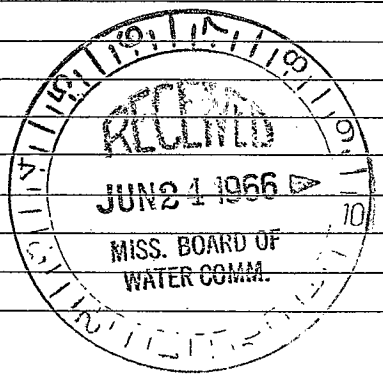

Mail this copy to Board of Water Commissioners 429 Miss. St. Jackson, Miss.

