

PANOLA
W5
11-22-71

MISSISSIPPI
 BOARD OF WATER COMMISSIONERS
 416 North State Street
 Jackson, Mississippi 39201

CODED 20 1971

WATER WELL DRILLERS LOG

MISS. RD. OF

Nov 22
 date well completed

1971 **LIPE WELL CO.**
 firm name


PANOLA
 county well located

LANDOWNER:	description of formations encountered	from	to
Bernard Phelps Courtland, Miss (mailing address)	top soil savel sand & clay sand	0 10 30 120	10 30 120 156
WELL LOCATION:			
sec. <u>12</u> T. <u>10</u> N. R. <u>6</u> E. <u>3</u> miles <u>W</u> of <u>Courtland</u> (distance) (direction) (nearest town)			
WELL PURPOSE: <u>resmo</u> (home, irrigation, municipal, industrial)			
WELL COMPLETION DATA:			
(1) diameter (inches) <u>4"</u>			
(2) total depth (feet) <u>156</u>			
(3) static water level (feet) <u>100</u> <u>below</u> top of ground.			
(4) casing <u>PVC</u> <u>146</u> (material) (depth) <u>4"</u> if telescope see back. (size)			
(5) screen <u>8</u> <u>146</u> (length) (depth to top) <u>4"</u> <u>PVC + silica</u> (size) (material)			
(6) pump <u>3/4</u> <u>10</u> (HP) (yield gpm) <u>elec</u> (type power)			
(7) electric log <u>no</u> (yes or no)			
(organization running log)			
(8) how well bottom plugged <u>PVC cap</u>			
DRILLERS REMARKS:			

CODED

If well telescopes please sketch and show depths.

GROUND LEVEL

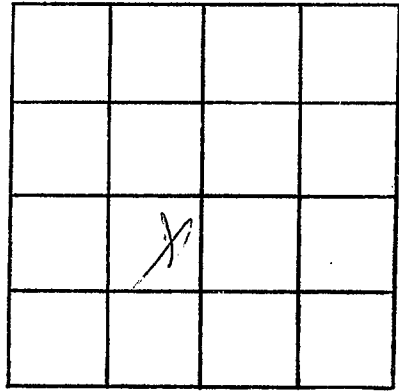

SECTION 12

Please indicate well location X.

ADDITIONAL INFORMATION

Lined area for additional information.

If more than one screen, show locations of each on sketch.