

MISSISSIPPI
BOARD OF WATER COMMISSIONERS
416 North State Street
Jackson, Mississippi 39201

CODED

WATER WELL DRILLERS LOG

PANOLA
W9
9-19-72

9-19 1972 JAMES A. LIFE Panola
date well completed firm name county well located

LANDOWNER:

MRS. Mesoley
POPE MISS,
(mailing address)

description of formations encountered

description of formations encountered	from	to
SAND	0	20
clay and sand	20	40
" " "	40	60
SAND	60	79

WELL LOCATION:

sec. 37 T 20 R 6 E
6 miles East of POPE
(distance) (direction) (nearest town)

WELL PURPOSE: HOME
(home, irrigation, municipal, industrial)

WELL COMPLETION DATA:

- diameter (inches) 4
- total depth (feet) 79
- static water level (feet) 6 below above top of ground.
- casing PVC, 69,
(material) (depth)
4 If telescope see back.
(size)
- screen 10, 69
(length) (depth to top)
4, PVC
(size) (material)
- pump 3/4, 8
(HP) (yield gpm)
ELEC.
(type power)
- electric log NO
(yes or no)
NO
(organization running log)
- how well bottom plugged PVC PVU

CODED


OCT - 8 1972

MISS. BD. OF
WATER COMMISSIONERS

DRILLERS REMARKS:

If well telescopes please sketch and show depths.

GROUND LEVEL

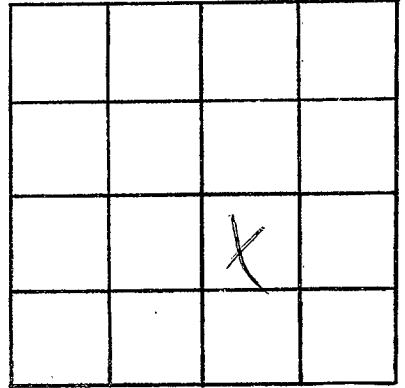

SECTION 30

Please indicate well location X.

ADDITIONAL INFORMATION

If more than one screen,
show locations of each on sketch.