

PANOLA

MISSISSIPPI BOARD OF WATER COMMISSIONERS

W 12

8-4-60

WATER WELL DRILLERS LOG

CODED

Date: 8-4, 1960, Driller: James R. Lipe (Name) County: Panola

(1) Owner of Land: Avery Cosby (Name) Courtland (Address)

(2) Location: 1/4, 1/4, Sec. 10 T. 276 N. R. 11 W. 1/2 miles (distance) West (direction) of Courtland (Nearest Town)

(3) Topography: (Hilly) (Flat) (Level)

(4) Purpose of Well: Dom (Domestic Irrigation, Municipal, Industrial, Other)

Information upon completion of well:

(1) Diameter 2 inches.

(2) Total Depth 116 feet.

(3) Water Level 100 feet below top of ground.

(4) Cased to 105, Size 2.

(5) Screen: Size 1 1/4, Length 6.


(6) Were any formations sealed against pollution? yes, no.

If YES depth of formation.

Why.

Drillers Remarks:

Table with 3 columns: Description & Color of Materials, Thickness Feet, Depth Feet. Entries include Top Soil & Clay, Clay, Gravel, Sand, and 1/2 inch sand.

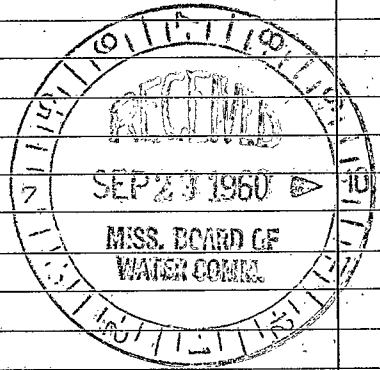

(Use Back Side)

Well No.

[The page contains extremely faint and illegible text, likely bleed-through from the reverse side of the document. The text is too light to transcribe accurately.]